


KANSAS

Butler county

Section 24 Township 25 Range 4-E

Well No. #6 Jackson "B"

Company Bennett & Abel

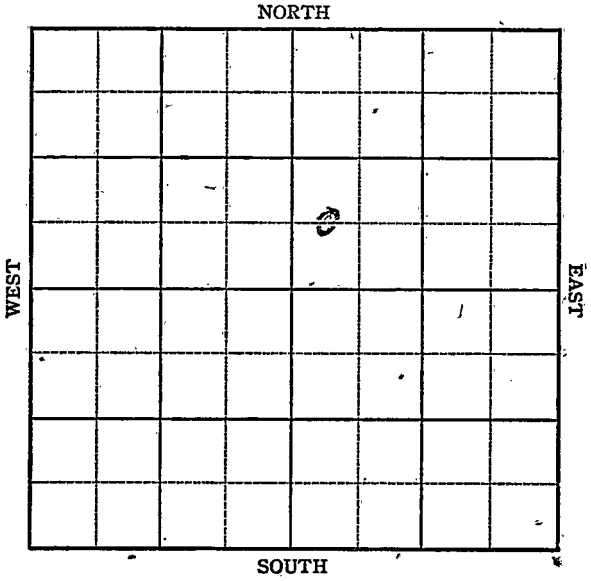

KANSAS

Butler

Sec. 24 Twp. 25 R. 4-E

Well No. #6 Jackson "B" Farm


Bennett & Abel Company

Ft. from N. Line

750 Ft. from S. Line

Ft. from E. Line

330 Ft. from W. Line

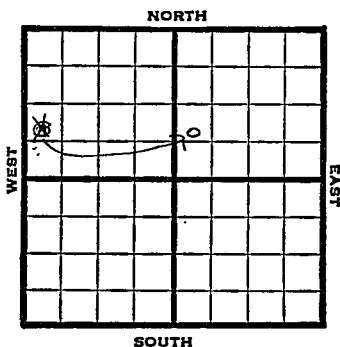

C W L SW NE

REPORT

1947 1393

2/5 Machine

2/12 Drlg 750'

2/19 15" @ 232
900 Run 12"

2/26 12" @ 900
10" @ 1765'
KO 2130'
Drlg 2170'

3/12 Miss 2599'
6" @ 2598
Pump 25 Pot
Grav. 38
TD 2619'

COMPLETED

Map No. 1d Sec. 24 Twp. 25 R. 4EWell No. 6 Jackson "B"Bennett & Abel CompanyCOMPLETE Contractor

C W L SW NE

E 11893
SECTION PLAT Ft. from N. Line750 Ft. from S. Line Ft. from E. Line330 Ft. from W. Line

		o	

Butler CountyLocation Rig up

Drilling and Remarks:

Miss 2599
6" @ 2598
Pump 2598

28° SW

RECORD

Cased in., ft.Sand Gas Oil Total Depth 2619

PRODUCTION

1st 24 hrs. Nat. 1st 24 hrs. after shot Gas Cu. Ft.Dry Hole Abandoned

Date

MAR 12 1947 19S. J. LEWIS Scout