


DX 78-1 Cowley

KANSAS

Section 2 Township 32 Range 6E

Well No. #2 Clodfelter

Company Sunray Mid-Continent

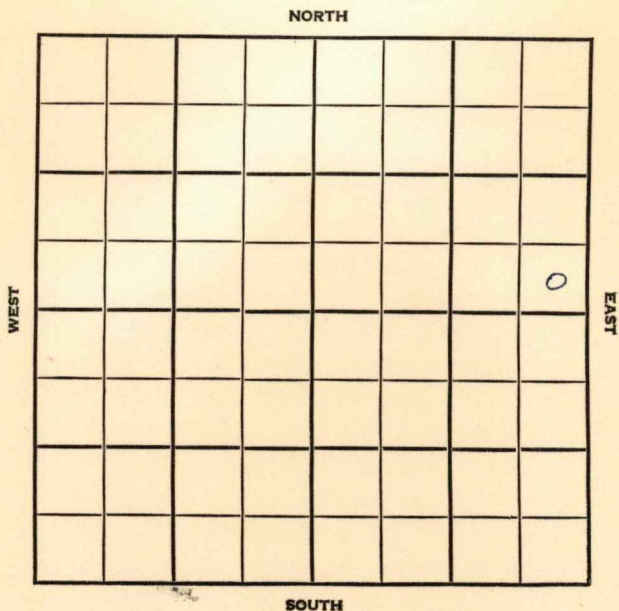

HOT FILE

Cowley

KANSAS

SEC.	TWP.	R.
2	32 S	6 E


WELL NO. # 2 Clodfelter FARM

COMPANY Sunray Mid-Continent (DEVELOPMENT)

CONTRACTOR Wakefield

Estes Field Area

_____ FT. FROM N. LINE -
 330 _____ FT. FROM S. LINE
 330 _____ FT. FROM E. LINE
 _____ FT. FROM W. LINE

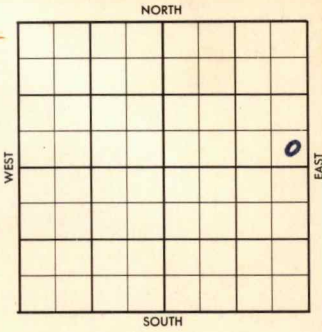

NE/4
SE SE NE

	ELEVATION	REPORT
1956	1391	
	2300' Layton Test	
8/8	Location	(FR Tkt)
8/10	Spud 8-9-56	
	Drlg. 50'	(DR#156)
8/13	TD 129'. WOC - 9-5/8" @ 129'	
8/14	TD 129'. WOC - 9-5/8" csg.	
8/15	Drlg. 600'	
8/16	Drlg. 1900'	
8/17	Drlg. 2115'	
8/20	TD 2260'. WOC - 5 1/2" @ 2258'	
8/21	TD 2260' MICT	
8/22	TD 2260'. Rng. EL	
8/23	TD 2260'. Prep to sqz. perfs 2201-2205'	
8/24	TD 2260'. WOC. Sqzd perfs 2201-2205'	
8/27	TD 2260'. Testing perfs 2190-94'	
8/28	TD 2260'. " "	
8/29	TD 2260'. " "	
8/30	TD 2260'. Flowed @ 24 BO Day Rate. Perfs 2190-94'. Layton Zone.	
	Complete	(DR#170)

COMPLETED

County Cowley Elev. Est 1385 DF
 Sec. 2 Temp. 32 Rgs. 6E 1391B7
 Company Sunray Mid-Continent
 Farm Name Clodfelter No. 2

	DEPTH	LOG	DATUM
Stall	1721		
Tr. Lay zn	2132		
Dg " sd	2171		
Bl.			
L.			
K.C.			
B.K.C.			
Ce.			
C.			
M.			
M.			
K.			
Mz.			
Mo.			
V.			
S.			
S.			
A.			
R.			
PE.			
G.			
TD	2260		

Loc. in Sec. SE SE NE
 Geol. Centr Wakefield
BURDEN
TOWNSITE
Estes
 COMPLETE
 SEP 12 '56

Date Comm. Location AUG 15 '56 / Surf w/ spudder
7-9-56 9 5/8 129 / 108 Wakefield
RUR AUG 22 '56 RTD 2260
5 1/2 @ 2258 / 100 2H MICT
Tops from Log AUG 29 '56 log tops Back dope
Stall 1721 Lay zn 2132 Lay sd
2171 Ord overall 2165 - 2236 Full
Rec. (2165-73 sandy sh. 2173 -
2188 1/2 Ed sd, fine grained gray, Pool

saturation crd. 2188 $\frac{1}{2}$ - 89 $\frac{1}{2}$ Coal
 2189 $\frac{1}{2}$ - 2222 Fine grain sd. Bleeding
 O&G 2222 - 2228 Fine gr. sd.
 Poorer saturation crd 2228 - 36
 Black green shale. — GRNh
 16/ 2201 - 05 tst 7 G0 + 40 Gw
 in 6 hrs sd w/100 ex. 16/
 2190 - 94 tst 3 Gw ph + sc.
 Oil 8 hrs. N4. \$ 4 B0 + Tr. wts
 1 hr Flow thru open thg
 23 B0 + 12 BW in 14 hrs. FP 0
 Fw 7 $\frac{1}{2}$ B0 + 2 $\frac{1}{2}$ BW in 6
 hrs TP 0 ^{SEP 5 '56} Flow 14 B0 +
 1 $\frac{1}{2}$ BW in 14 hrs 1 $\frac{1}{32}$ " ch.
 TP 140# Flwd 16 B0 ^{no/10}
 1 $\frac{1}{32}$ " ch 16 hrs TP 140#
 Flwd 15 B0 20 to wts 3 $\frac{1}{4}$ "
 ch TP 65# ^{SEP 12 '56} X comp.
 Lay sd PF15 2190 - 94
 RTP 2260

County Cowley Elev. _____
 Sec. 2 Twp. 32 Rge. 6E
 Company Sunray Mid-Continent
 Farm Name Clodfelter No. 2

TOPS	DEPTH	LOG	DATUM
Anh.			
Tp.			
H.			
Tr.			
Dg.			
Bl.			
L.			
K.C.			
B.K.C.			
Ce.			
C.			
M.			
M.			
K.			
Mz.			
Mq.			
V.			
S.			
S.			
A.			
R.			
PE.			
G.			
T.D.			

Loc. in Sec. SE SE NE

Geol. _____

Contr. _____

Pool

Estes

FIRST REPORT

AUG 8 56

Date Comm. _____
 Location Location

SEP 21 1956

M.M.

Co.

Sec.

No.

Sec.

T.

R.