

Butler


KANSAS

SECTION 24 TOWNSHIP 25S RANGE 4E

WELL NO. #2 Murray "A"

COMPANY Fultz & Gates

NORTH

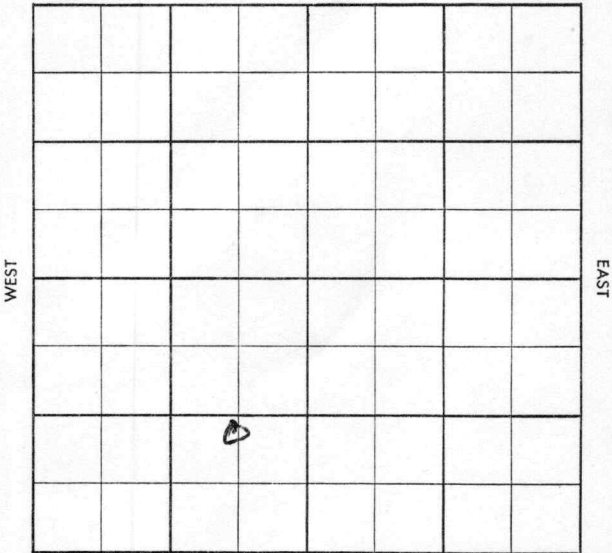

SOUTH

CO. Butler ELEV. 1365
 SEC. 24 TWP. 25 RGE. 4E
 COMPANY Fultz & Gates NO. 2

FIRST REPORT	
SEP 25	57
0	

FARM MurrayLOC. N/2 SE SW 800' fsl x 2000' fwl of Sec.

GEOL. _____

CONTR. Co. ToolsPOOL EldoradoSPUD 9-6-57

8" @ 243 (Shallow hole),

Shall Sd. 705, TD 711,

7" @ 702 Prep to cement

CO.

SEC.

NO.

SEC.

TWP.

RGE.

CORRECTION

S-513-A

CO. Butler ELEV. 1365 04 OCT 30 57
 SEC. 24 TWP. 25 RGE 4E COMPLETE
 COMPANY Fultz & Gates NO. 2
 FARM Murray "A"
 LOC. N/2 SE SW 800' fsl x 2000' fwl of Sec.

GEOL. _____
 CONTR. Co. Tools
 POOL Eldorado
 SPUD 9-6-57
8" @ 243 (Shallow hole),
Shall Sd. 705, TD 711,
7" @ 702 Prep to cement
OCT 2 57 CO 711
2 to 3 Bopd
Proc OCT 9 57

FU 325 fcl 260' oil
POB on ld
P 3 to 4 Bopd lot of w

CO.
 NO.
 SEC.
 TWP.
 RGE.