

Cowley

KANSAS

SECTION 1 TOWNSHIP 32 RANGE 6E

WELL NO. #7 G.O. Brooks

COMPANY The Texas Co.

NORTH

|  |  |  |  |  |  |  |  |
|--|--|--|--|--|--|--|--|
|  |  |  |  |  |  |  |  |
|  |  |  |  |  |  |  |  |
WEST

EAST

SOUTH

Cowley

KANSAS


|      |      |     |
|------|------|-----|
| SEC. | TWP. | R.  |
| 1    | 32   | 6 E |

WELL NO. #7 G. O. Brooks FARM

COMPANY The Texas Co.

CONTRACTOR Capitt Drlg Tools  
Estes

\_\_\_\_\_ FT. FROM N. LINE  
 \_\_\_\_\_ FT. FROM S. LINE  
 \_\_\_\_\_ FT. FROM E. LINE  
 \_\_\_\_\_ FT. FROM W. LINE

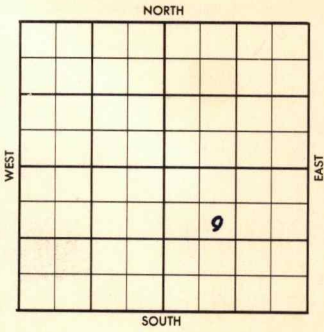

SE NW SE

|      |           |        |
|------|-----------|--------|
| 1956 | ELEVATION | REPORT |
|------|-----------|--------|

9-12  
 Comm 9-5-56  
 10" @ 124 w/125  
 Drlg 500

County Cowley Elev. \_\_\_\_\_  
 Sec. 1 Twp. 32 Rgs. 6E  
 Company The Texas Co.  
 Farm Name G. O. Brooks No. 7

| TOPS   | DEPTH | LOG | DATUM | Loc. in Sec. |
|--------|-------|-----|-------|--------------|
| Anh.   |       |     |       | SE NW SE     |
| Tp.    |       |     |       |              |
| H.     |       |     |       |              |
| Tr.    |       |     |       |              |
| Dg.    |       |     |       |              |
| Bl.    |       |     |       |              |
| L.     |       |     |       |              |
| K.C.   |       |     |       | Geol. _____  |
| B.K.C. |       |     |       | Contr. _____ |
| Ce.    |       |     |       |              |
| C.     |       |     |       | Capitt Drlg. |
| M.     |       |     |       | Tools        |
| M.     |       |     |       | Pool         |
| K.     |       |     |       | Estes        |
| Mz.    |       |     |       |              |
| Mq.    |       |     |       |              |
| V.     |       |     |       |              |
| S.     |       |     |       |              |
| S.     |       |     |       |              |
| A.     |       |     |       |              |
| R.     |       |     |       |              |
| Pe.    |       |     |       |              |
| G.     |       |     |       |              |
| T.D.   |       |     |       |              |

SEPT 12 1956  
 FIRST REPORT  
 0

Date Comm. 9/5/56  
10" @ 124 w/125, Drlg. 500

SEP 12 1956  
 SEP 12 1956

500

Co.  
 Loc.  
 No.  
 Sec.  
 T.  
 R.

Co.

Use

No.

Sec.

T.

R.

County Cowley Elev. 1315

Sec. 1 Twp. 32 Rge. 6E

Company The Texas Co.

Farm Name G. O. Brooks No. 7

| TOPS                 | DEPTH       | LOG | DATUM | Loc. in Sec.  |
|----------------------|-------------|-----|-------|---|
| Anh.                 |             |     |       | <u>SE NW SE</u>   |
| TP.                  |             |     |       | <div style="border: 1px solid black; padding: 5px; transform: rotate(-45deg); display: inline-block;">                     Borden<br/>Townsite                 </div> |
| H. <u>Stall sd</u>   | <u>1718</u> |     |       |   |
| Tr.                  |             |     |       |   |
| Dg.                  |             |     |       |   |
| Bl.                  |             |     |       |   |
| L. <u>1844</u>       |             |     |       |   |
| N.C. <u>Group</u>    | <u>2068</u> |     |       |   |
| BKG. <u>Cott gr.</u> | <u>2112</u> |     |       |   |
| Ge. <u>KCL</u>       | <u>2184</u> |     |       |   |
| C.                   |             |     |       |   |
| M.                   |             |     |       | <u>Capitt Drlg.</u>   |
| M.                   |             |     |       | <u>Tools</u>  |
| K.                   |             |     |       | <u>Pool</u>   |
| Mz.                  |             |     |       | <u>Estes</u>  |
| Me.                  |             |     |       |   |
| V.                   |             |     |       |   |
| S.                   |             |     |       |   |
| S.                   |             |     |       |   |
| A.                   |             |     |       |   |
| R.                   |             |     |       |   |
| PE.                  |             |     |       |   |
| G.                   |             |     |       |   |
| TD.                  | <u>2191</u> |     |       |   |

COMPLETE

OCT 3 '56

Date Comm. 9/5/56

10" @ 124 w/125, Drlg. 500 SEP 19 '56

7" @ 2190/175 co 2157 13/

2122-26 B 12 GW + Troil E' Gas

SEP 26 '56 Frac B 23 B0 + 123

BW 15 hrs tst 5 B0 +

25 BW 5 hrs sod (w/diesel)

B 7 1/2 G0 no/w 3 hrs 12/

2117-21 B 34 GW (SSD + Gas)

3 hrs Frac B 1d OCT 3 '56 B

62 B0 + 236 BW 12 hrs

P. 53 B0 + 223 BW 24  
hrs