


Kansas

Map No. _____ Sec. 6 Twp. 25 R. 6

Well No. 1 Carter Farm _____
C.O. Buckles Company _____

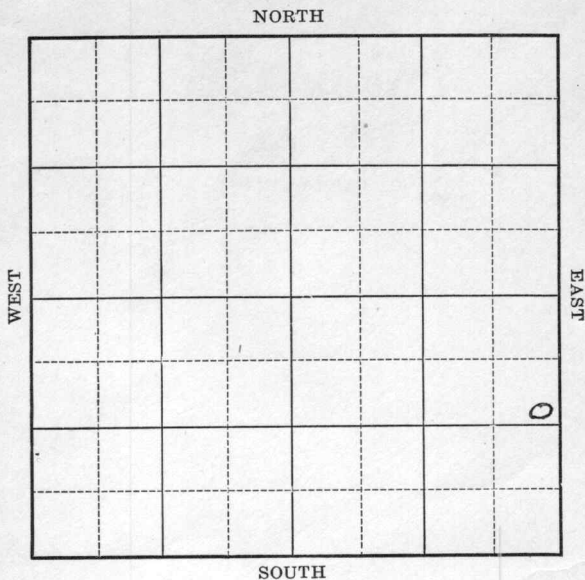

Location _____

Drilling Remarks:

RECORD

Cased _____ in. _____ ft.

Sand _____

Gas _____

Oil _____

Total Depth _____

COMPLETED

Rig Up _____

Drilling Remarks:

PRODUCTION

1st 24 hrs. Nat. _____

1st 24 hrs. after shot _____

Gas _____ cu. ft.

Dry Hole _____

Abandoned _____

Map No. Gas 14 Sec. 6 Twp. 25 R. 6

Well No. 1 Carter

C. O. Buckler Company

Contractor

FIRST REPORT

SECTION PLAT

1120 Ft. from N. Line

_____ Ft. from S. Line

200 Ft. from E. Line

_____ Ft. from W. Line

			○

Location _____

Rig up _____

Drilling and Remarks:

Rig up
up

RECORD

Cased _____ in., _____ ft.

Sand _____

Gas _____

Oil _____

Total Depth _____

PRODUCTION

1st 24 hrs. Nat. _____

1st 24 hrs. after shot _____

Gas _____ Cu. Ft.

Dry Hole _____

Abandoned _____

Date

JUL 15 1922

M. A. BENEAR

191

Scout

Map No. ~~KANSAS~~ ¹⁴ Sec. 6 Twp. 25 R. 6

Well No. 1 Carter

C. O. Buckles Company

Contractor

ABANDONED SECTION PLAT

1120 Ft. from N. Line

_____ Ft. from S. Line

200 Ft. from E. Line

_____ Ft. from W. Line

			0

Location _____

Rig up _____

Drilling and Remarks:

RECORD

Cased _____ in., _____ ft.

Sand _____

Gas _____

Oil _____

Total Depth _____

PRODUCTION

1st 24 hrs. Nat. _____

1st 24 hrs. after shot _____

Gas _____ Cu. Ft.

Dry Hole ✓ _____

Abandoned 2803 _____

Date

SEP 16 1922

191 _____

M. A. BENEAR

Scout