


Cowley

KANCAS

SECTION # 20 TOWNSHIP 32 RANGE 5E

WELL NO. #1 Files

COMPANY McNeish & Gralapp

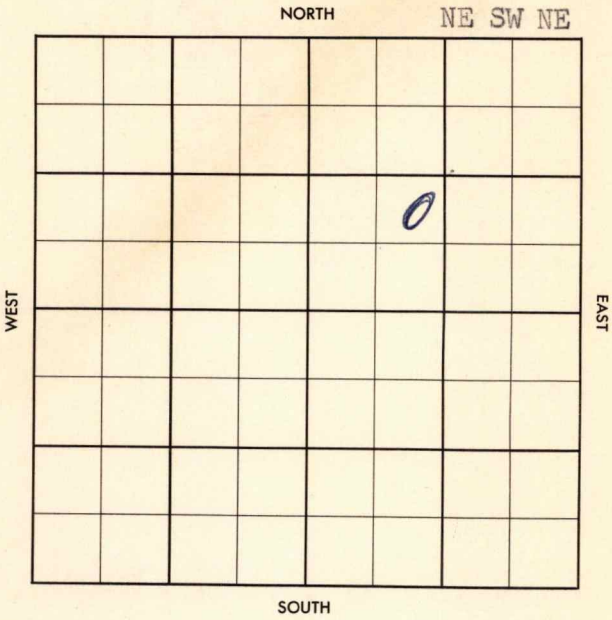

County Cowley Elev. \_\_\_\_\_  
 Sec. 20 Twp. 32 Rge. 5E  
 Company McNeish & Gralapp  
 Farm Name Files No. 1

TOPS	DEPTH	LOG	DATUM	Loc. in Sec.
Anh.				NE SW NE
Tp.				
H.				
Tr.				
Dg.				
Bl.				
L.				Geol. _____
K.C.				Contr. _____
B.K.C.				
Ce.				Co. Tools
C.				
M.				Pool
M.				Frog Hollow
K.				
Mz.				
Me.				
V.				
S.				FIRST REPORT
S.				
A.				
R.				
PE.				JUN 12 57
G.				
T.D.				

Date Comm. 6-8-57  
 8" @ 200, Drlg. 600

*29*

Co.  
Lse.  
No.  
Sec.  
T.  
R.

County Cowley Elev. 1283  
 Sec. 20 Twp. 32 Rge. 5E  
 Company McNeish & Gralapp  
 Farm Name Files No. 1

TOPS	DEPTH	LOG	DATUM
Anh.			
Tr.			
H. <u>stain</u>	<u>1957</u>		
Tr. <u>lay</u>	<u>2376</u>		
Dg.			
Bl.			
L.			
K.C.	<u>2556</u>		
B.K.C. <u>OSW</u>	<u>2752</u>		
Ce. <u>Bartizn</u>	<u>3029</u>		
M. <u>" sd</u>	<u>3049</u>		
M.			
K.			
Mz.			
Mq.			
V.			
S.			
S.			
A.			
R.			
Pe.			
G.			
T.D.	<u>3069</u>		

Loc. in Sec. NE SW NE  
 Geol. \_\_\_\_\_  
 Contr. \_\_\_\_\_  
 Co. Tools \_\_\_\_\_  
 Pool \_\_\_\_\_  
 Frog Hollow \_\_\_\_\_

**ABANDONED**  
 JUN 26 '57

Date Comm. 6-8-57  
 8" @ 200, Drlg. 600 JUN 19 57 JUN 26 57

*D & A*