

Cowley


32

6E

Section 4 Township _____ Range _____

Well No. 1 Ayers

Company J. G. Ripstra

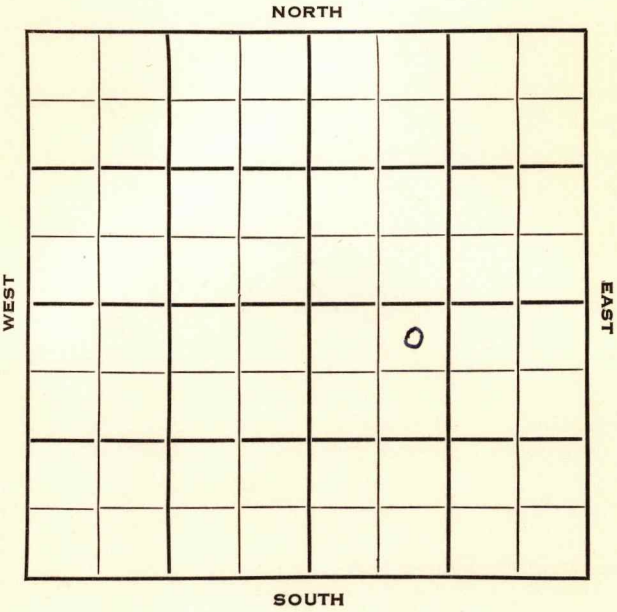

SEC.	TWP.	R.
4	32	6 E

WELL NO.

1 Ayers

FARM

COMPANY

J. G. Ripstra

CONTRACTOR

Saturn Drlg.


330 Ft. from N. Line

Ft. from S. Line

Ft. from E. Line

990 Ft. from W. Line

NE NW SE

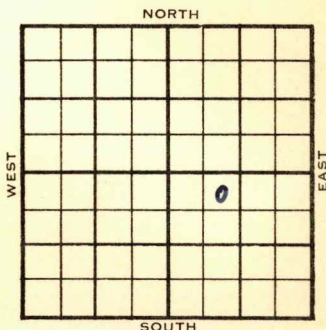

ELEVATION	REPORT
1953	1353'

11/4 Location

11/24 Spud 11-13-53

D&A

TD 3116'

8" @ 119'

Severy sd 1070', Top. 1177', Stal.

1910', Lans 2049', Layton 2414',

KC 2427', Oswego 2738', Checkerboard

2810', Bart 2902'

TD 3116'

D&A

ABANDONED

County **Cowley** State **Kansas**

Sec. 4 (Blk.) 32 (Sur.) 6 E Map No.

Operator J. G. Ripstra

Well No. **1** Farm **Ayers**

[illegible]

330 Ft. From N Line SE

990 Ft. From **W** Line Quarter

1st. Report NOV 4 1953

Completion

Remarks

Saturn Drlg. - Contr.

Spudding Date _____

Drlg. Data	
Location	

J. G. McGEHEE

County Cowley State Kansas
 Sec. 4 (Blk.) 32 (Sur.) 6E Map No.
 Operator J. G. Ripstra
 Well No. 1 Farm Ayers
 Elev. 1353 Location NE NW SE



330 Ft. From N Line SE
990 Ft. From W Line Quarter

1st. Report

Completion NOV 24 1953

Remarks

Saturn Drlg. - Contr.

Spudding Date 11-13-53

Drlg. Data D & A TD 3116

8" @ 119 Severy sd. 1070 Top. 1177

Stal. 1910 Lans. 2049 Layton 2414

KC 2427 Oswego 2738 Checkerboard 2810

Bart. 2902 TD 3116

D & A

J. G. McGEHEE