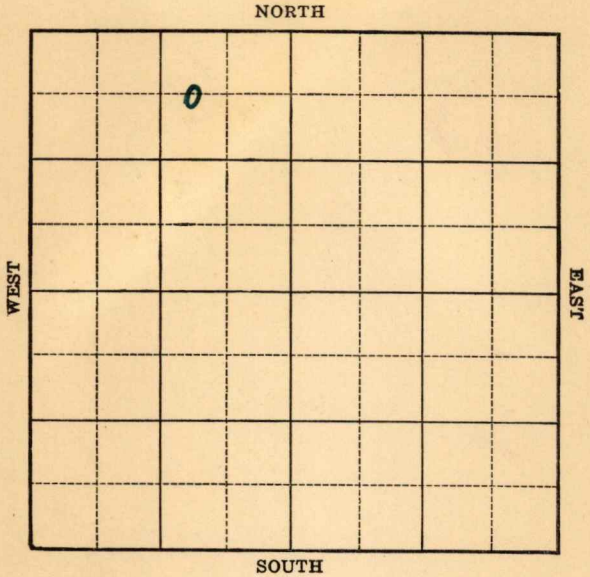
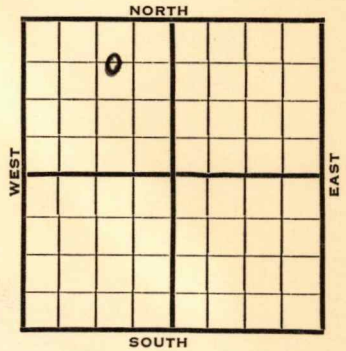


Section 21 Township 32 Range 5EWell No. #4 DyersCompany Hawkeye

KANSAS

Cowley

FORM 252-A 5M 2-40

Sec. 21 Twp. 32 R. 5-EWell No. #4 Byers FarmHawkeye Company660 Ft. from N. Line Ft. from S. Line990 Ft. from E. Line Ft. from W. Line

Elev. 1334

1940

REPORT

7/10

S.H. 40'

7/18

10" - 81' Drlg. 2395'

7/25

5" - 3060' RUST.

8/2

T.D. 3079' Flow 70 bbls. oil pe
hour.

8/7

Bart. 3059'

5½" - 3059'

T.D. 3079'

Flow 1157 bbls.

COMPLETED

Map No. 2 Sec. 21 Twp. 32 R. 5EWell No. 4 ByersHawkeye

Company

Contractor

FIRST REPORT

C W L NE NW

660 Ft. from N. Line Ft. from S. Line990 Ft. from E. Line Ft. from W. Line

SECTION PLAT

	0		

Location Rig up

Drilling and Remarks:

S.H. 40

RECORD

Cased in., ft.Sand Gas Oil Total Depth

PRODUCTION

1st 24 hrs. Nat. 1st 24 hrs. after shot Gas Cu. Ft.Dry Hole Abandoned

Date

JUL 10 1940

19

S. J. LEWIS Scout

Map No. 2 Sec. 21 Twp. 32 R. 5EWell No. 4 ByersHawkeye

Company

Contractor

COMPLETED

C W L NE NW

660 Ft. from N. Line Ft. from S. Line990 Ft. from E. Line Ft. from W. Line

SECTION PLAT

	0		

Location Rig up

Drilling and Remarks:

*Bar 8059**5 1/2 @ 8059**Flow 1157*

RECORD

Cased in., ft.Sand Gas Oil Total Depth 3079

PRODUCTION

1st 24 hrs. Nat. 1st 24 hrs. after shot Gas Cu. Ft.Dry Hole Abandoned

Date

AUG 7 1940 19

S. J. LEWIS Scout