


Section 20 Township 32 Range 5-E

Well No. #2 Scott

Company H. H. Blair
Miscellaneous

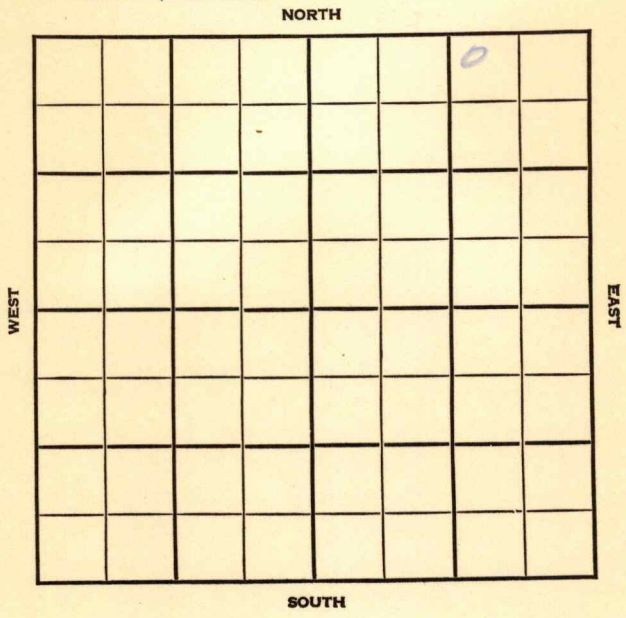

KANSAS

Cowley

Sec. 20 Twp. 32 R. 5E

Well No. #2 Scott Farm

H. H. Blair Company

Miscellaneous


330' Ft. from N. Line

_____ Ft. from S. Line

990' Ft. from E. Line

_____ Ft. from W. Line

NW NE NE

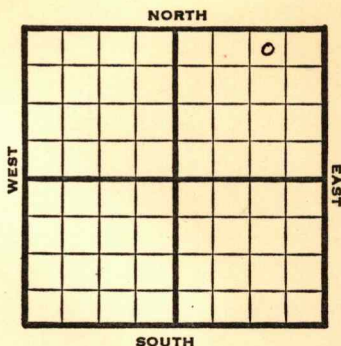

1948

Elev. 1288'

REPORT

5/19 8" @ 108'
Drlg. 1765'

5/26 **Bart 3031-33'**
TD 3033'
5" @ 3031'

6/1 "

6/9 TD 3044'
15 qts CO

6/16 "

6/23 TD 3044'
Bart 3031'
5" @ 3031'
Pump 25 oil pot
38⁰ Gr.

Comp

COMPLETED

Map No. _____ Sec. 20 Twp. 32 R. 5E

Well No. 2 Scott

H. H. Blair Company

FIRST REPORT Contractor

NW NE NE

SECTION PLAT

			0

330 Ft. from N. Line

_____ Ft. from S. Line

990 Ft. from E. Line

_____ Ft. from W. Line

Cowley County

Location _____

Rig up _____

Drilling and Remarks:

8" @ 108

drlg. 1765

RECORD

Cased _____ in., _____ ft.

Sand _____

Gas _____

Oil _____

Total Depth _____

PRODUCTION

1st 24 hrs. Nat. _____

1st 24 hrs. after shot _____

Gas _____ Cu. Ft.

Dry Hole _____

Abandoned _____

Date

MAY 19 1948 19

S. J. LEWIS Scout

Kansas

Map No. 2 Sec. 20 Twp. 32 R. 5E

Well No. 2 Scott

H. H. Blair Company

COMPLETE

Contractor

NW NE NE

E. 11258
SECTION PLAT

			5

330 Ft. from N. Line

_____ Ft. from S. Line

990 Ft. from E. Line

_____ Ft. from W. Line

Cowley County

Location _____

Rig up _____

Drilling and Remarks:

Bar 3031

5' 10" 3031

Run 25 oil

35-3

RECORD

Cased _____ in., _____ ft.

Sand _____

Gas _____

Oil

Total Depth 3044

PRODUCTION

1st 24 hrs. Nat. _____

1st 24 hrs. after shot _____

Gas _____ Cu. Ft.

Dry Hole _____

Abandoned _____

Date

JUN 23 1948 19

S. J. LEWIS Scout