


Cowley

KANSAS

Section 21 Township 32 Range 5-E


Well Number 2 Cairns

Company Gulf

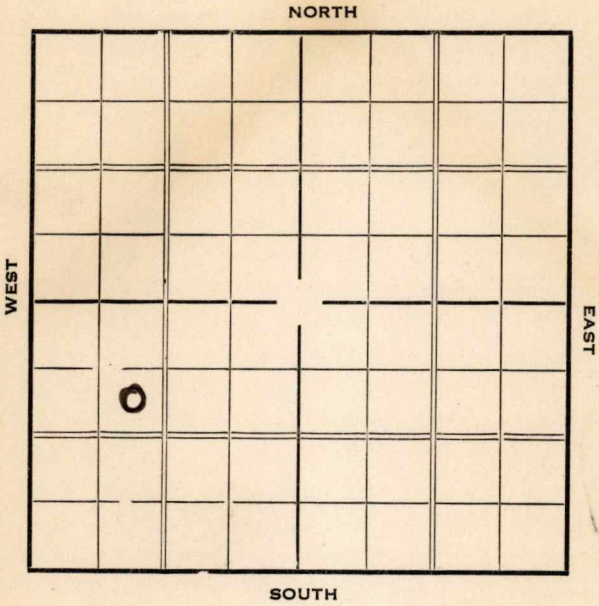

Sec. 21 Twp. 32 R. 5-EWell No. #2 Cairns Farm
Gulf Company990 Ft. from N. Line Ft. from S. Line Ft. from E. Line990 Ft. from W. Line

Elev. 1282

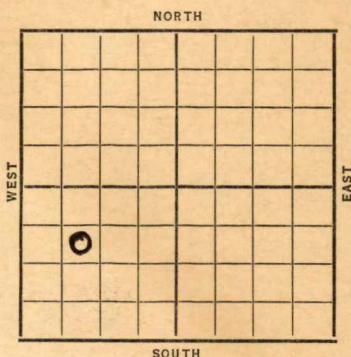

Date	REPORT
1937	
4/21	Location
4/30	Rig.
5/7	Spud
5/14	Drlg. 935'.
5/21	13" @ 1093'. Drlg. 1475'.
5/28	10" @ 1615'. T.D. 1773'.
	Fsg.
6/4	Drlg. 2132'.
6/11	10" @ 1773'. Drlg. 2525'.
6/19	8" @ 2525'. 6" @ 3016'. WOC.
6/25	Drlg. 3065'. 1900' water.
7/2	T.D. 3132'. SDO
7/9	" " "
7/14	Sand 3120'.
	T.D. 3132'.
	H.F.W.
	ABANDONED

KANSAS*Cowley*Map No. 2 Sec. 21 Twp. 32 R. 5EWell No. 2 Cairns*Guff*

Company

Contractor

SECTION PLAT

990 Ft. from N. Line

_____ Ft. from S. Line

_____ Ft. from E. Line

990 Ft. from W. Line**FIRST REPORT**Location ✓

Rig up _____

Drilling and Remarks:

RECORD

Cased _____ in., _____ ft.

Sand _____

Gas _____

Oil _____

Total Depth _____

PRODUCTION

1st 24 hrs. Nat. _____

1st 24 hrs. after shot _____

Gas _____ Cu. Ft.

Dry Hole _____

Abandoned _____

Date

APR 21 1937

19

S. J. LEWIS Scout

Cowley KANSAS

Map No. 2 Sec. 21 Twp. 32 R. 5^EWell No. 2 - Cairns EstateGulf

Company

Contractor

ABANDONED

SECTION PLAT

0			

990 Ft. from N. Line

_____ Ft. from S. Line

_____ Ft. from E. Line

990 Ft. from W. Line

Location _____

Rig up _____

Drilling and Remarks:

HFW

D & A

RECORD

Cased _____ in., _____ ft.

Sand 3120

Gas _____

Oil _____

Total Depth 3132

PRODUCTION

1st 24 hrs. Nat. _____

1st 24 hrs. after shot _____

Gas _____ Cu. Ft.

Dry Hole _____

Abandoned _____

Date
JUL 14 1937

19

H. D. Hatfield

Scout