


Section 21 Township 32 Range 5-E

Well No. 1 Chance

Company T. J. Archer et al

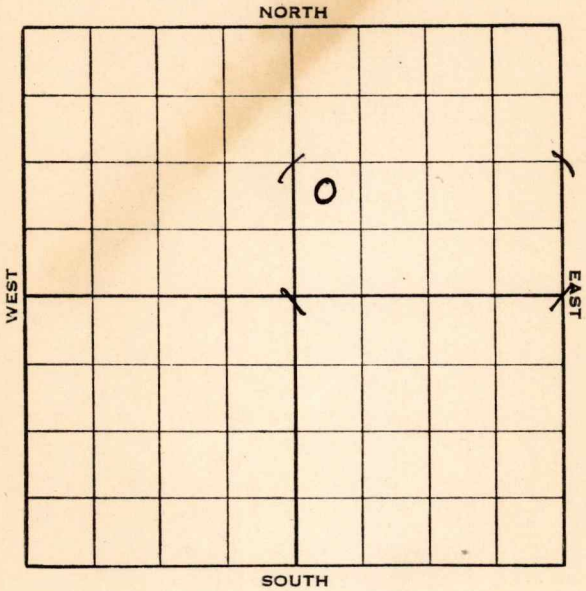



1938

10/26 5" - 3033'.

Bart. 3033'.

T. D. 3056'.

P. B. 3054'.

Potential 272 bbls. oil & 17  
water; in 8 hours.

COMPLETED

Map No. 2 Sec. 21 Twp. 32 R. 5E

Well No. 1 Chance

T. J. Archer etal Company

Contractor

FIRST REPORT

NW SW NE


\_\_\_\_\_ Ft. from N. Line

990 Ft. from S. Line

\_\_\_\_\_ Ft. from E. Line

330 Ft. from W. Line

SECTION PLAT

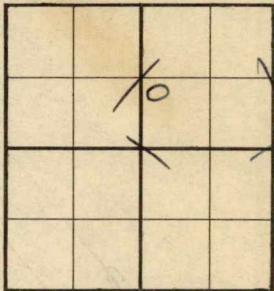

Location \_\_\_\_\_

Rig up \_\_\_\_\_

Drilling and Remarks:

**SPUD**

RECORD

Cased \_\_\_\_\_ in., \_\_\_\_\_ ft.

Sand \_\_\_\_\_

Gas \_\_\_\_\_

Oil \_\_\_\_\_

Total Depth \_\_\_\_\_

PRODUCTION

1st 24 hrs. Nat. \_\_\_\_\_

1st 24 hrs. after shot \_\_\_\_\_

Gas \_\_\_\_\_ Cu. Ft.

Dry Hole \_\_\_\_\_

Abandoned \_\_\_\_\_

Date

AUG 24 1938

Map No. 2 Sec. 21 Twp. 32 R. 5E

Well No. 1-Chance

T J Archer etal Company

Contractor

**COMPLETED**

NW SW NE

**SECTION PLAT**

		0	

         Ft. from N. Line

990 Ft. from S. Line

         Ft. from E. Line

330 Ft. from W. Line

Location                                 

Rig up                                 

Drilling and Remarks:

*P.B. 3054*

*Rot 272  
17 wtr in 8 hrs*

**RECORD**

Cased 5 in., 3033 ft.

Sand Bart 3032

Gas                                 

Oil                                 

Total Depth 3056

**PRODUCTION**

1st 24 hrs. Nat.                                 

1st 24 hrs. after shot                                 

Gas                                  Cu. Ft.

Dry Hole                                 

Abandoned                                 

Date

*OCT 26 1938*

19

*H. D. Hatfield*

Scout