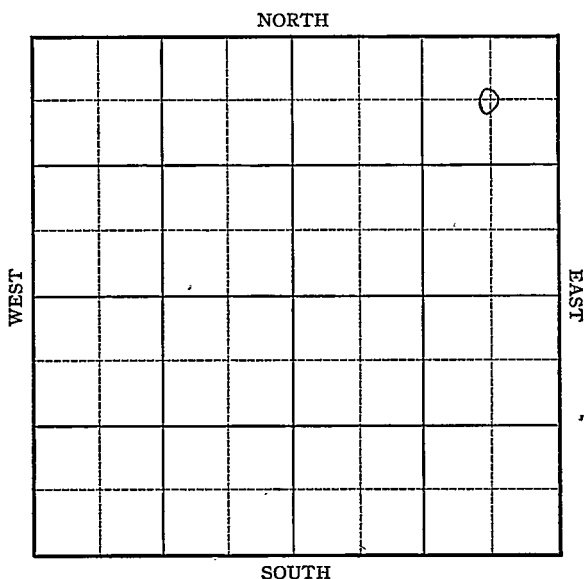


KANSAS

Ellsworth

FORM 51 5M 1-42 PETROL

Section 33 Township 16 Range 10-WWell No. #2 J. SchroederCompany Magnolia

KANSAS

Ellsworth

Sec. 33 Twp. 16 R. 10-W

Well No. #2 J. Schroeder Farm

Magnolia Company

Stoltenberg


660 Ft. from N. Line

 Ft. from S. Line

660 Ft. from E. Line

 Ft. from W. Line

Elev. 1817

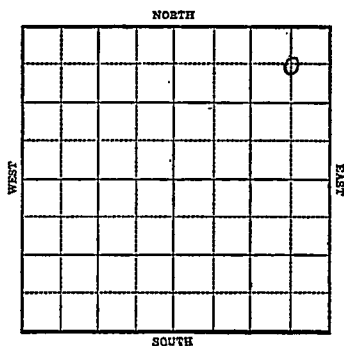

1943

R E P O R T

3/17 Location.

3/24 Cellar.

3/31 10" @ 242 WOC

4/7 Drlg. 2775'

4/41 Lans 2925

Arb 3264

T.D. 3271 SSO

7" @ 3265' RUST.

4/21 T.D. 3278-2000 acid

Pump 10 oil per hr 8 hrs.

4/28 Arb. 3264

7" @ 3265'

T.D. 3278'

2000 gal. acid

Pump 227 Pot.

Gravity 44.4

COMPLETED

KANSAS

Ellsworth

Map No. 25 Sec. 33 Twp. 16 R. 10WWell No. 2 J. SchroederMagnolia

Company

FIRST REPORT

Contractor

C NE NE

SECTION PLAT

660 Ft. from N. Line Ft. from S. Line660 Ft. from E. Line Ft. from W. Line

			o

STOLTENBERG POOL

Location XXXRig up

Drilling and Remarks:

RECORD

Cased in., ft.Sand Gas Oil Total Depth

PRODUCTION

1st 24 hrs. Nat. 1st 24 hrs. after shot Gas Cu. Ft.Dry Hole Abandoned

Date

MAR 17 1943

19S. J. LEWIS

Scout

Ellsworth

KANSAS
 Map No. 53 Sec. 33 Twp. 16 R. 10W

Well No. 2 J. Schroeder

Magnolia

Company

COMPLETED

Contractor

C NE NE

SECTION PLAT

660 Ft. from N. Line

Ft. from S. Line

660 Ft. from E. Line

Ft. from W. Line

STOLTENBERG POOL

Location

Rig up

Drilling and Remarks:

*Ac 83264**7" C 3265**2000 Acid**Pump 227 P.D.**44 1/2 Gr*

RECORD

Cased _____ in., _____ ft.

Sand _____

Gas _____

Oil _____

Total Depth *2228*

PRODUCTION

1st 24 hrs. Nat. _____

1st 24 hrs. after shot _____

Gas _____ Cu. Ft.

Dry Hole _____

Abandoned _____

Date

APR 28 1943 19

S. J. LEWIS Scout