

KANSAS


Ellworth

FORM 51 5M PETROL

Section 33 Township 16 Range 10-W

Well No. #1 Stoltenberg (Stoltenberg)

Company Cities Service Oil

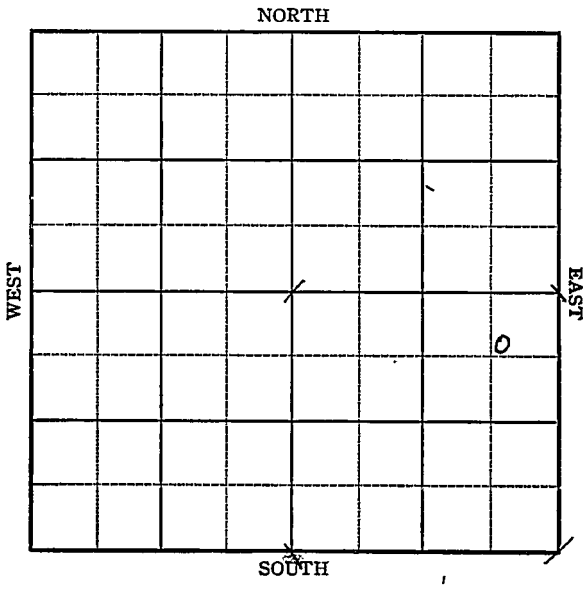

Sec. 33 Twp. 16 R. 10-W

Well No. #1 Stoltenberg Farm


Cities Service Oil Company

555 Ft. from N. Line

_____ Ft. from S. Line

550 Ft. from E. Line

_____ Ft. from W. Line

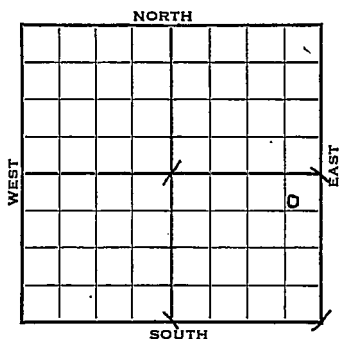

1943

Elev. 1827

REPORT

8/18

Location

8/25

8" @ 243'
WOC.

9/1

Drlg. 2962

9/8

Lans 2983
Arb 3269
5" @ 3271
T.D. 3299
Swab $1\frac{1}{2}$ oil per hr.

9/15

T.D. 3293-2500 acid

9/22

T.D. 3297'
Swb 40 oil in 24 hrs.

9/29

1500 acid
Swab 33 oil in 4 hrs.

10/6

" " " " "

10/13

" " " " "

10/20

" " " " "

10/27

" " " " "

11/3

" " " " "

11/10

" " " " "

11/17

" " " " "

OVER

1943
11/24

5" @ 3271'
Arb. 3269
4000 Acid
Pump 113 Pot.
Grav. 42.2 °
TD 3297'

COMPLETED

KANSAS

Map No. 55 Sec. **33** Twp. **16** R. **10W**

Well No. **1 Stoltenberg**

Cities Service Oil Company

FIRST REPORT Contractor

C NE SE

555 Ft. from N. Line


_____ Ft. from S. Line

550 Ft. from E. Line

_____ Ft. from W. Line

STOLTENBERG POOL.

SECTION PLAT

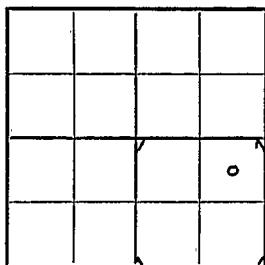

Location **X**

Rig up _____

Drilling and Remarks:

RECORD

Cased _____ in., _____ ft.

Sand _____

Gas _____

Oil _____

Total Depth _____

PRODUCTION

1st 24 hrs. Nat. _____

1st 24 hrs. after shot _____

Gas _____ Cu. Ft.

Dry Hole _____

Abandoned _____

Date

AUG 1 8 1943 19

S. J. LEWIS Scout

KANSAS

Map No. JJ Sec. 33 Twp. 16 R. 10W

Well No. 1 Stoltenberg

Cities Service Oil Company

COMPLETED Contractor

C NE SE

SECTION PLAT

555 Ft. from N. Line

_____ Ft. from S. Line

550 Ft. from E. Line

_____ Ft. from W. Line

			o

Stoltenberg Pool

Location _____

Rig up _____

Drilling and Remarks:

Cr & 3269
5" C 3271
4000 acid
Pump 113 R & Y

422 Gr

RECORD

Cased _____ in., _____ ft.

Sand _____

Gas _____

Oil _____

Total Depth 3297

PRODUCTION

1st 24 hrs. Nat. _____

1st 24 hrs. after shot _____

Gas _____ Cu. Ft.

Dry Hole _____

Abandoned _____

Date

NOV 24 1943 19

S. J. LEWIS Scout