


Section 21 Township 32 Range 5-E


Well Number 1 Moon

Company McKnabb

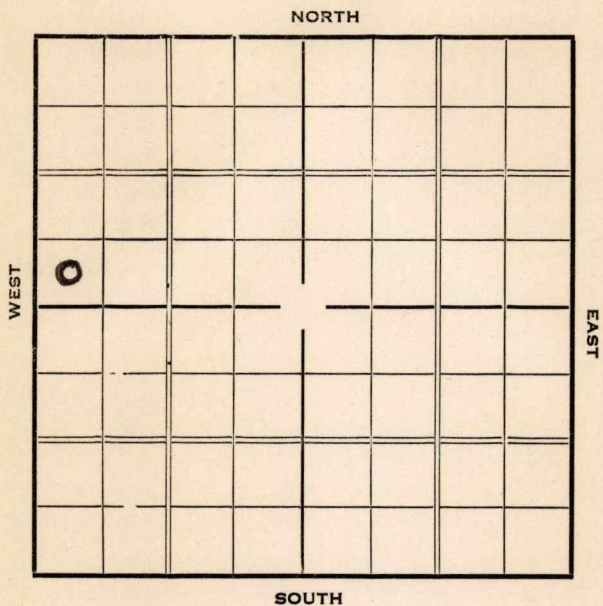

Sec. 21 Twp. 32 R. 5-EWell No. #1 Moon FarmMcKnabb Company Ft. from N. Line330 Ft. from S. Line Ft. from E. Line330 Ft. from W. Line

Elev. 1325

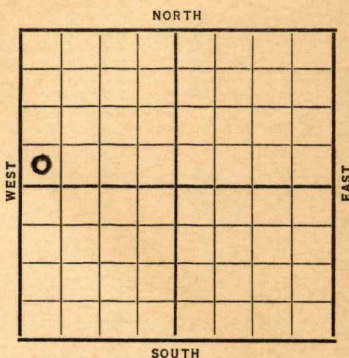

Date	REPORT
1937	
4/14	Location
4/23	"
4/30	"
5/7	Ponds.
5/14	"
5/21	"
5/28	"
6/4	"
6/11	"
6/19	"
6/25	"
7/2	"
7/9	"
7/16	"
7/23	B. R.
7/30	R. U.
8/6	Sphd.
8/13	15" @ 460'. Drlg. 900'.
8/20	12" @ 1143'. Drlg. 1725'.
8/28	Drlg. 2200'.

OVER

1937				
9/3	Drl g.	2400'		
9/10	"	"		
9/17	6"	@ 3160'	WOC.	
9/24	"	"	"	"
10/2	"	"	"	"
10/8	T.D.	3057'	C.O.	
10/15	"	"	"	
10/22	"	"	"	
10/29	"	"	"	
11/5	"	"	"	
11/12	"	"	"	
11/19	"	"	"	
11/26	"	"	"	
12/3	5"	@ 3063'	WOC.	
12/10	Bart.	3067'	T.D. 3082'	
	1000'	oil.	Shut down.	
12/17	Flowed	360 bbls.	oil 8 hrs.	
12/22	5"	@ 3063'		
	Bart.	3067'		
	T.D.	3082'		
	Flowed	104 bbls.	4 hrs and	
	62 bbls.	4 hrs.		
	Potential	373 bbls.		

COMPLETED

KANSAS Crowley

Map No. 2 Sec. 21 Twp. 32 R. 5E-7Well No. 1 MoonMc Knatt Company

Contractor

SECTION PLAT

0			

 Ft. from N. Line330 Ft. from S. Line Ft. from E. Line330 Ft. from W. Line

FIRST REPORT

Location ✓Rig up

Drilling and Remarks:

RECORD

Cased in., ft.Sand Gas Oil Total Depth

PRODUCTION

1st 24 hrs. Nat. 1st 24 hrs. after shot Gas Cu. Ft.Dry Hole Abandoned

Date

APR 14 1937 19

S. J. LEWIS

Scout

Cowley **KANSAS**Map No. 2 Sec. 21 Twp. 32 R. 5EWell No. 1-MoonMcNabb

Company

Contractor

COMPLETED

SW NW

 Ft. from N. Line330 Ft. from S. Line Ft. from E. Line330 Ft. from W. Line**SECTION PLAT**

0			

Location Rig up

Drilling and Remarks:

flowed
10 4/4 + 6 2/4
POT-372

RECORDCased 5 in., 3063 ft.Sand BART 3067Gas Oil Total Depth 3082**PRODUCTION**1st 24 hrs. Nat. 1st 24 hrs. after shot Gas Cu. Ft.Dry Hole Abandoned

Date

DEC 22 1937 19

H. D. Hatfield

Scout