


Ellsworth

KANSAS

Section 33 Township 16 Range 10W

Well No. #5 Stoltenberg

Company Cities Service

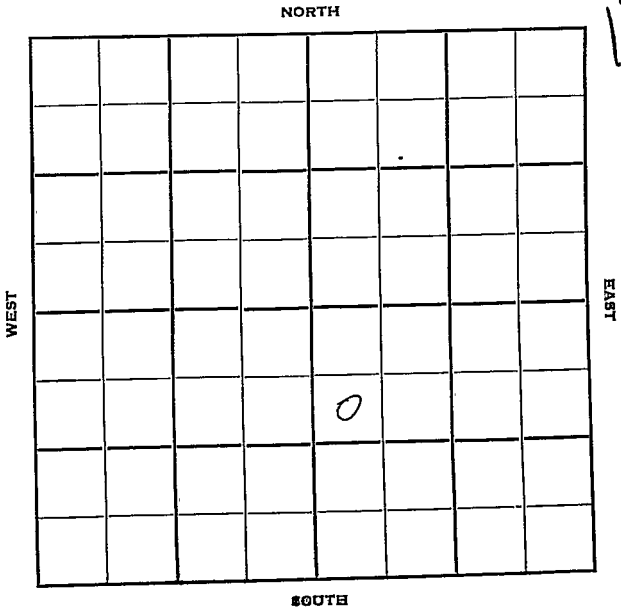

KANSAS

Ellsworth

Sec. 33 Twp. 16 R. 10 ~~W~~

Well No. #5 Steltenberg Farm

Cities Service

Company

Stoletnberg

Contractor


990 Ft. from N. Line

_____ Ft. from S. Line

_____ Ft. from E. Line

330 Ft. from W. Line

SW NW SE

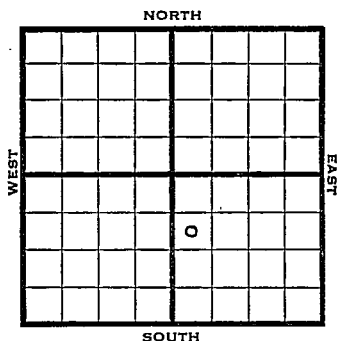

1950

Elev 1833

REPORT

8/30 Location

10/4

Spud 9-3-50

8" @ 305 TD 3286

Lans 2972

Arb 3275

TD 3276

5" @ 3276

DD 3282

P 39 bo 10 hr

1000 A

DD 3286

Comp 95 hopd

Completed

COMPLETED

County **Ellsworth** State **Kansas**

Sec. **33** (Blk. **16** (Sur. **10W** Map No.

Operator **Cities Service**

Well No. 5 Farm Stoltenberg

Elev.	Location	SW	NW	SE
-------	----------	----	----	----

A 10x10 grid with a bold cross dividing it into four 5x5 quadrants. The text "FIRST REPORT" is written diagonally across the center, and a small circle is in the bottom-right quadrant.

990 Ft. From N Line SE

530 Ft. From W Line Quarter

1st. Report AUG 30 1950

Completion

Remarks

Spudding Date

Drig. Data	Stoltenberg Pool
Location	

County Ellsworth State Kansas

Sec. 33 (Blk. Twp.) 16 (Sur. Rge.) 10W Map No.

Operator Cities Service

Well No. 5 Farm Stoltenberg

Elev.	1833	Location	SW NW SE
-------	------	----------	----------

990 Ft. From N Line SE

330 Ft. From W Line Quarter

1st. Report _____

Completion OCT 4 1950

Remarks Stoltenberg Pool

Spudding Date 9-3-50

Drig. Data Oil well TD 3286

8" @ 305 Lans. 2972 Arb. 3275

TD 3276 5" @ 3276 DD 3282 P. 39 bo 10 hr

1000 A DD 3286 Comp. 95 bopd

J. E. TYRA