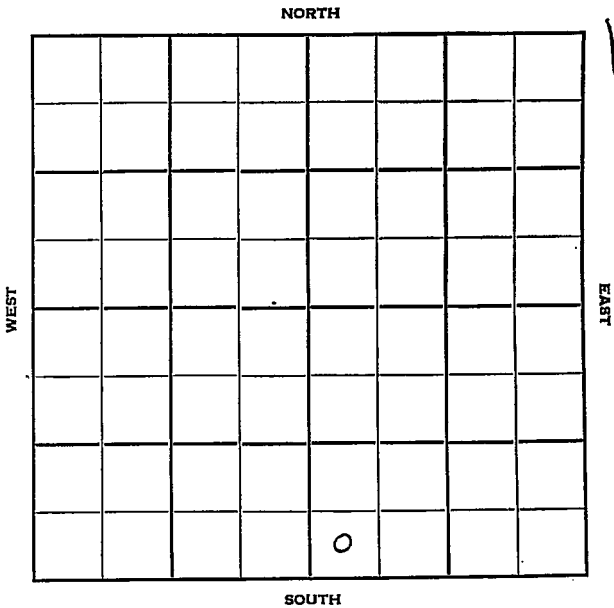


Section 33 Township 16 Range 10 WWell No. # 6 StoltenbergCompany Cities Service

Ellsworth

KANSAS

Sec. 33 Twp. 16 R. 10 W

Well No. # 6 Stoltenberg Farm

Cities Service Company

Contractor


Ft. from N. Line

330 Ft. from S. Line

Ft. from E. Line

330 Ft. from W. Line

SW SW SE

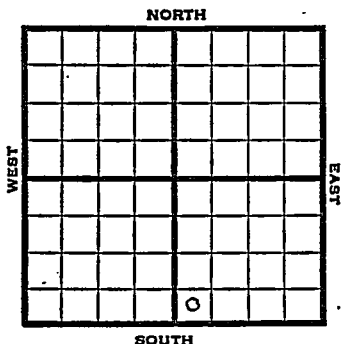

1951

Elev. 1830'

REPORT

4/25

Spud 4-22-51

Brlg. 200'

6/5

Spud 4-22-51

Oil Well TD 3306

8" @ 290 Lans. 2965

Arb. 3274

TD 3275 5" @ 3275 TD 3306

P/68 bo 15 hr. Comp. 362 bopd

COMPLETED

Sec. 33 (Blk. Twp.) 16 (Sur. Rge.) 10W Map No.

Well No. 6 Farm Stoltenberg

Elev.	1830	Location	SW SW SE
-------	------	----------	----------

COMPLETE

330 Ft. From S Line SE

330 Ft. From W Line Quarter

1st. Report _____

Completion JUN 6 1951

Remarks _____

Spudding Date 4-22-51

Drlg. Data Oil well TD 3306

8" @ 290 Lans. 2965 Arb. 3274

TD 3275 5" @ 3275 DD 3306 P/ 68 bo

15 hr. Comp. 362 bopd

J. E. TYRA