

KANSAS

Form 51-5M-7-40-Palace

Ellsworth


Section 34 Township 16 Range 10-W

Well No. #1 Matosh

Company Atlantic & Gulf

NORTH

Ehler Pool

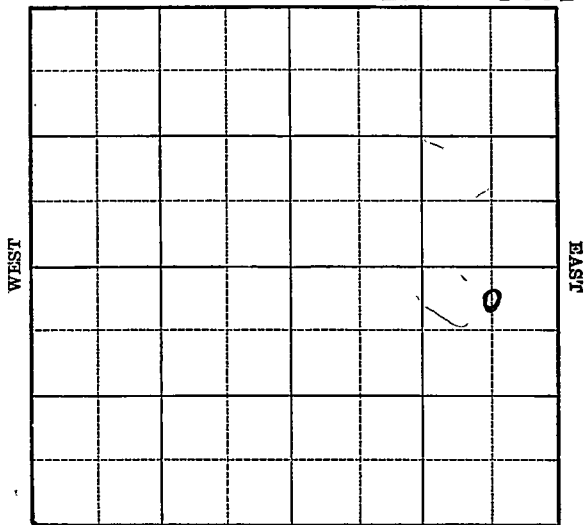

SOUTH

KANSAS

Ellsworth

FORM 252-A 5M 2-40

Sec. 34 Twp. 16 R. 10-WWell No. #1 Matosh FarmAtlantic & Gulf

Company

(Ehler)

330 Ft. from N. Line


Ft. from S. Line

660 Ft. from E. Line

Ft. from W. Line

Elev. 1815

-1463

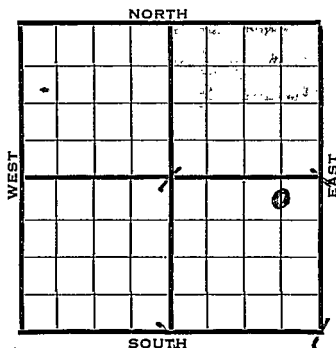

1940	REPORT
7/31	10" - 345' WOC.
8/9	Drlg. 2822'
8/9	Top Lansing 2940'
	Drlg. 3000' (Tel)
8/12	Top Arbuckle 3278 T.D. 3282 good show
	oil Good porosity 3279-82
	Running 5 $\frac{1}{2}$ " 3278 (Tel)
8/14	R.U.S.T.-S.D.
8/16	T.D. 3284 swab 1/2 bbl oil per hour for 4 hours
	Shot 6 qts on bottom C.O. (Tel)
8/22	T.D. 3284' 2000 acid. $\frac{1}{2}$ Bbls
	oil per hour 4 hours.
	Shot 6 qts. 3280-84' C.O.
8/23	Acidized 800 gallons & 1700 gallons
	Swab 5 bbls. oil per hour off bottom
	Will reacidize with 2000 gallons (Tel)
8/29	T.D. 3293 ³²⁹³ 2000' oil in hole
	48 hours.

OVER

1940

9/4

Arb. 3278'

5" = 3278'

T.D. 3293' (Corrected)

6 qts. 3280-84'

8500 acid.

Potential 186 bbls., pump.

COMPLETED


Map No. 55 Sec. 34 Twp. 16 R. 10WWell No. 1 MatoshAtlantic & Gulf

Company

Contractor

FIRST REPORTC $N\frac{1}{2}$ NE SE330 Ft. from N. Line Ft. from S. Line660 Ft. from E. Line Ft. from W. Line**EHLER POOL**SpecialLocation Rig up

Drilling and Remarks:

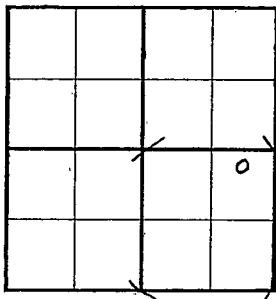10" 345**Woc****SECTION PLAT****RECORD**Cased in., ft.Sand Gas Oil Total Depth **PRODUCTION**1st 24 hrs. Nat. 1st 24 hrs. after shot Gas Cu. Ft.Dry Hole Abandoned

Date

JUL 31 1940 19 41S. J. LEWIS Scout

Map No. _____ Sec. 34 Twp. 16 R. 10WWell No. 1 MatoshAtlantic & Gulf

Company

Contractor

COMPLETEDC $N\frac{1}{2}$ NE SE330 Ft. from N. Line

_____ Ft. from S. Line

660 Ft. from E. Line

_____ Ft. from W. Line

SECTION PLAT

			o

EHLER POOL

Location _____

Rig up _____

Drilling and Remarks:

*at 3278**5" @ 3278 3278**69 to 3280-84**8500 acid**Pump 186 P.S.***RECORD**

Cased _____ in., _____ ft.

Sand _____

Gas _____

Oil _____

Total Depth *3293 corrected***PRODUCTION**

1st 24 hrs. Nat. _____

1st 24 hrs. after shot _____

Gas _____ Cu. Ft.

Dry Hole _____

Abandoned _____

Date

SEP 4 1940

19

S. J. LEWIS Scout