


SECTION 1 TOWNSHIP 32 RANGE 6 E

WELL NO. #1 Quier

COMPANY H. H. Blair & Paul Deputy

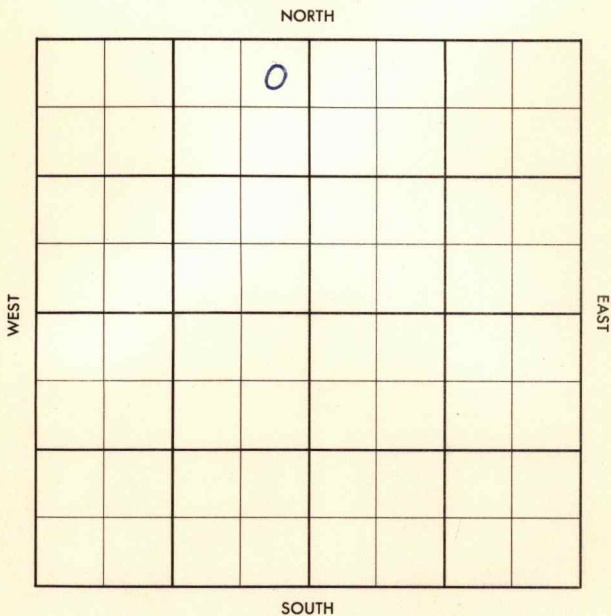



County Cowley Elev. \_\_\_\_\_  
 Sec. 1 Twp. 32 Rge. 6E  
 Company H. H. Blair & Paul Deputy  
 Farm Name Quier No. 1

TOPS	DEPTH	LOG	DATUM	Loc. in Sec.
Anh.				NE NE NW
TP.				
H.				
Tr.				
Dg.				
Bl.				
L.				Geol. _____
K.C.				Contr. _____
B.K.C.				<u>Bedell &amp; Cat</u>
Ce.				
C.				Pool _____
M.				<u>Estes</u>
M.				
K.				
Mz.				
Me.				
V.				
S.				
S.				
A.				
R.				
Pe.				
G.				
TD.				

o  
 FIRST REPORT  
 DEC 14 '55  
 1/2 mile

Date Comm. \_\_\_\_\_  
 Location \_\_\_\_\_

\_\_\_\_\_  
 \_\_\_\_\_  
 \_\_\_\_\_  
 \_\_\_\_\_  
 \_\_\_\_\_  
 \_\_\_\_\_

Co.  
 No.  
 Sec.  
 T.  
 R.

County Cowley Elev. 1400

Sec. 1 Twp. 32 Rge. 6E

Company H. H. Blair & Paul Deputy

Farm Name Quier No. 1

TOPS	DEPTH	LOG	DATUM	Loc. in Sec.
Anh.				NE NE NW
Tp.				
H.				
Tr.				
Dg.				
Bl.				
L. <u>ayton</u>	<u>2157</u>		<u>7.57</u>	Geol.
K.C.				Contr.
B.K.C.				<u>Bedell &amp; Cat</u>
Ce.				Pool
C.				<u>Estes</u>
M.				
M.				
K.				
Mz.				
Me.				
V.				
S.				
S.				
A.				
R.				
Pe.				
G.				
T.D.	<u>2195</u>			

Date Comm. 12-31-55 JAN 25 1956

8 5/8" @ 102 DST 2161-76 open 1 hr.

gas to surface in 1 1/2 min. 1,500 mcfg

775# DST 2181-90 open 1 hr.

1 mcfg 775# 5 1/2" @ 2193 DD 2202

4 mcfgpd Comp. 3,920 mcfgpd