


Cowley

KANSAS

Section 30 Township 32 Range 6E

Well No. 3 Cranston

Company Deep Rock

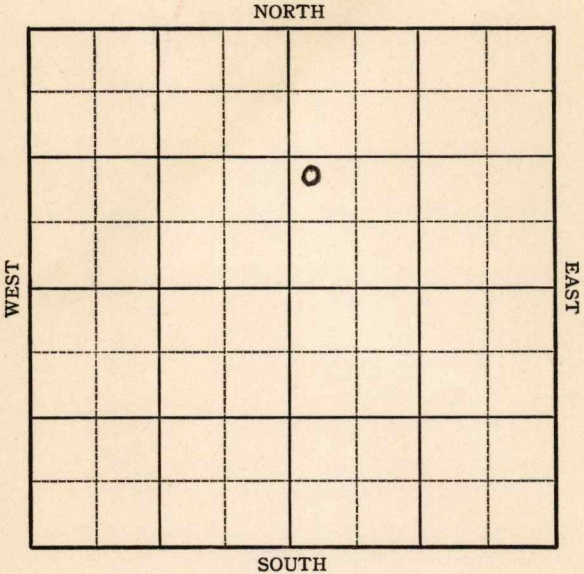


KANSAS

Cowley

Sec. 30 Twp. 32 R. 6-EWell No. #3 Cranston FarmDeep Rock Company         Ft. from N. Line1030 Ft. from S. Line         Ft. from E. Line330 Ft. from W. Line

Elev. 1227

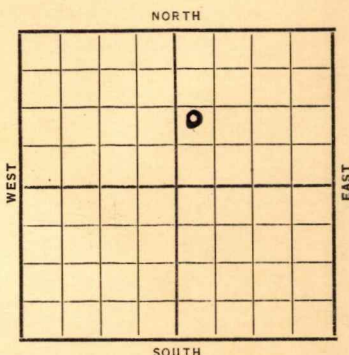

| Date  | REPORT                                    |
|-------|-------------------------------------------|
| 1937  |                                           |
| 12/1  | Location                                  |
| 12/10 | Mat.                                      |
| 12/17 | Drlg. 640'.                               |
| 12/24 | 12" @ 77'. Drlg. 2045'.                   |
| 12/31 | Coring 2253'.                             |
| 1938  |                                           |
| 1/7   | Chat 2994'. Miss 3004'.                   |
|       | Drlg. 3080'. No shows.                    |
| 1/14  | Drlg. 3303'.                              |
| 1/20  | Base Miss 3380'                           |
|       | Arb 3440' T.D. 3447' S.O.                 |
|       | 7" - 3440' R.U.S.T.                       |
| 1/28  | Drlg. 3503' Wil make salt water disposal. |
| 2/4   | TD 3510' 3100' Water S.D.                 |
| 2/11  | " " " "                                   |
| 2/18  | " " " "                                   |
| 2/26  | " " " "                                   |
| 3/4   | " " " "                                   |
| 3/11  | " " " "                                   |

OVER

1938

3/18 TD 3510' SD.  
3100' water.

3/25 " "

4/1 " "

4/8 " "

4/15 " "

4/22 " "

4/29 " "

5/6 " "

5/12 " "

5/20 " "

5/25 7" @ 3440'.

Arb. 3440'.

T.D. 3510'.

3100' water in hole.

Will make salt water disposal  
well. No test.

ABANDONED

Cowley

KANSAS

Map No. 2 Sec. 30 Twp. 32 R. 6EWell No. 3 CranstonDeep Rock

Company

Contractor

## FIRST REPORT

NW SW NE

       Ft. from N. Line1030 Ft. from S. Line       Ft. from E. Line330 Ft. from W. Line

## SECTION PLAT

|  |  |   |  |
|--|--|---|--|
|  |  |   |  |
|  |  | 0 |  |
|  |  |   |  |
|  |  |   |  |

Location XRig up       

Drilling and Remarks:

## RECORD

Cased        in.,        ft.Sand       Gas       Oil       Total Depth       

## PRODUCTION

1st 24 hrs. Nat.       1st 24 hrs. after shot       Gas        Cu. Ft.Dry Hole       Abandoned       

Date

DEC 1 - 1937 .19

H. D. Hatfield Scout

Cowley

KANSAS

Map No. 2 Sec. 30 Twp. 32 R. 6EWell No. 3 CranstonDeep Rock

Company

Contractor

COMPLETED

NW SW NE

Ft. from N. Line

1030 Ft. from S. Line

Ft. from E. Line

330 Ft. from W. Line

## SECTION PLAT

|  |  |   |  |
|--|--|---|--|
|  |  |   |  |
|  |  | 0 |  |
|  |  |   |  |
|  |  |   |  |

Location

Rig up

Drilling and Remarks:

*3100' wtr in hole**will make salt  
water disposal  
well - No Test.*

## RECORD

Cased 7 in., 3440 ft.Sand Arb 3440

Gas

Oil

Total Depth 3510

## PRODUCTION

1st 24 hrs. Nat. \_\_\_\_\_

1st 24 hrs. after shot \_\_\_\_\_

Gas \_\_\_\_\_ Cu. Ft.

Dry Hole \_\_\_\_\_

Abandoned \_\_\_\_\_

Date

MAY 25 1938 19

H. D. Hatfield

Scout