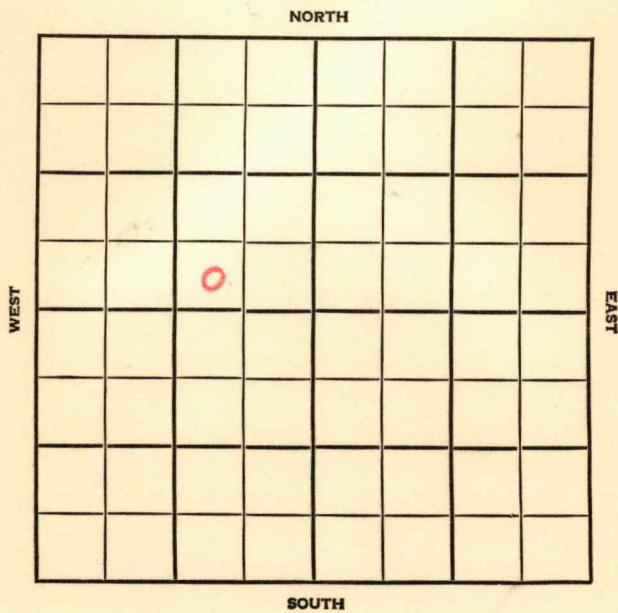


Section 22 Township 32 Range 7EWell No. #1 ReidyCompany E. K. Edminston etal

Cowley

KANSAS

SEC.

22

HOT FILE

TWP.

32

R.

7E

WELL NO.

1 Reidy

FARM

COMPANY

E. K. Edminston et al

CONTRACTOR

Kriswell

Wildcat

Ft. from N. Line

330'

Ft. from S. Line


990'

Ft. from E. Line

Ft. from W. Line

SW SE NW

OFFSET SDX

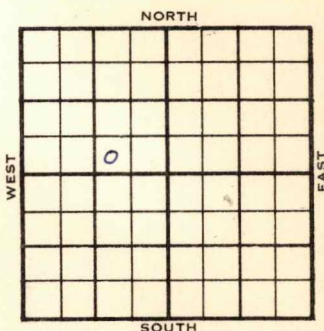

1955

ELEVATION

1359'

REPORT

5/25

Location

6/2

Spud 5-28-55  
8-5/8" @ 84

6/9

Drlg. 2075'

6/15

Comm 5-28-55  
8 5/8" @ 84H. Stal 1653, Tr. Layton 2066,  
KC 2273, BKC Cleve 2412, Ce Oswego  
2561, C. Ce 2635, Miss 2898

TD 2950

D &amp; A

ABANDONED

County Cowley State Kansas

Sec. 22 (Blk. Twp.) 32 (Sur. Rge.) 7E Map No.

Operator E. K. Edminston et al.

Well No. 1 Farm Reidy

| Elev. | Location | SW | SE | NW |
|-------|----------|----|----|----|
|-------|----------|----|----|----|

330 Ft. From S Line NW

990 Ft. From **E** Line Quarter

1st. Report MAY 25 1955

### Completion

Remarks

Kriswell - Contr.

Spudding Date

Drlg. Data Wildcat

Location

FIRST REPORT

|           |                        |      |       |         |
|-----------|------------------------|------|-------|---------|
| County    | Cowley                 |      | Elev. | 1359    |
| Sec.      | 22                     | Twp. | 32    | Rge. 7E |
| Company   | E. K. Edminston et al. |      |       |         |
| Farm Name | Reidy                  |      | No.   | 1       |

| TOPS                 | DEPTH       | LOG | DATUM       | Loc. in Sec.   |
|----------------------|-------------|-----|-------------|---|
| Anh.                 |             |     |             | SW SE NW   |
| Tr.                  |             |     |             |   |
| H. <i>Stal</i>       | <i>1653</i> |     | <i>294</i>  |   |
| Tr. <i>Layton</i>    | <i>2066</i> |     | <i>707</i>  |   |
| Dg.                  |             |     |             |   |
| B.L.                 |             |     |             |   |
| L.                   |             |     |             |   |
| K.C.                 | <i>2273</i> |     | <i>914</i>  | Geol.   |
| B.K.C. <i>Cleave</i> | <i>2412</i> |     | <i>1653</i> | Contr.   |
| Ce. <i>Oswego</i>    | <i>2561</i> |     | <i>1202</i> | Kriswell   |
| C. <i>Ce</i>         | <i>2635</i> |     | <i>1276</i> |   |
| M. <i>iss</i>        | <i>2898</i> |     | <i>1539</i> |   |
| M.                   |             |     |             | Pool   |
| K.                   |             |     |             | Wildcat   |
| Mz.                  |             |     |             |   |
| Mq.                  |             |     |             | <div style="border: 1px solid black; padding: 5px; text-align: center;">             8<br/> <b>ABANDONED</b> </div> |
| V.                   |             |     |             |   |
| S.                   |             |     |             |   |
| S.                   |             |     |             |   |
| A.                   |             |     |             |   |
| R.                   |             |     |             |   |
| P.                   |             |     |             |   |
| G.                   |             |     |             |   |
| T.D.                 | <i>2950</i> |     |             |   |

|             |         |             |
|-------------|---------|-------------|
| Date Comm.  | 5-28-55 | JUN 15 1955 |
| 8 5/8" @ 84 |         |             |

D &amp; A