


Map No. _____ Sec. 18 Twp. 25 R. 6
 Well No. 1 Haylett Belk #2 Farm _____
Gypsy Oil Company _____

NORTH

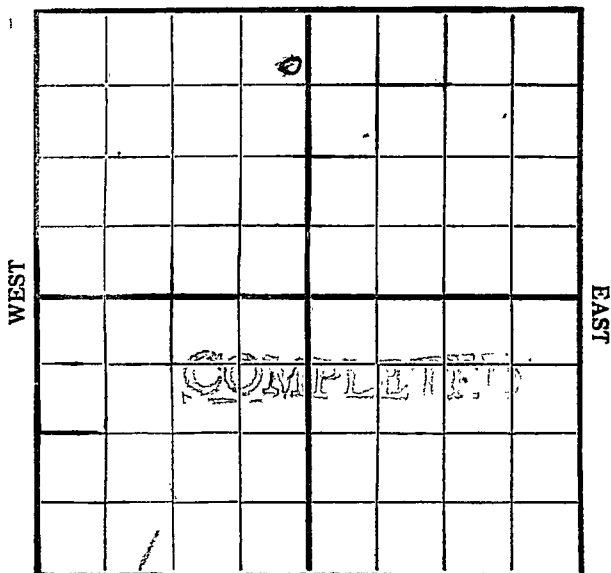

SOUTH

Location _____

Rig Up _____

Drilling Remarks:

Drilling Remarks:

RECORD

Cased _____ in. _____ ft.

Sand _____

Gas _____

Oil _____

Total Depth _____

PRODUCTION

1st 24 hrs. Nat. _____

1st 24 hrs. after shot _____

Gas _____ cu. ft.

Dry Hole _____

Abandoned _____

Map No. _____ Sec. 18 Twp. 25 R. 6Well No. 1. Hazlett Farm _____Cypsy Orsco Company _____


Contractor _____

_____ Quarter NW460 Ft. from N. Line

_____ Ft. from S. Line

700 Ft. from E. Line


_____ Ft. from W. Line

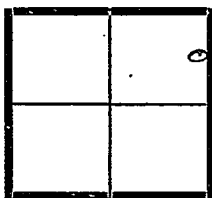Date 10/1/19

REPORT

10/1 Dreg. 1200'
10/24 10 bar hole 1920
10/31 had Lacc 1920'
11/8 Bad Lacc 2260'
13 Drl 2300
22 A.D. 2400' for water
26 Drl 2430
12/6 Set 6 7/8 2440'
13 Dreg. 2500'
19 Set 6 7/8 2590'
23 Dreg. 2585'
1/4/20 A.D. 2585'
6 Dry abandoned 2515'

Map No. K14 Sec. 18 Twp. 25 R. 16
 Well No. 1 Hazlett Block # 2
Graham Oil Company _____ Contractor _____

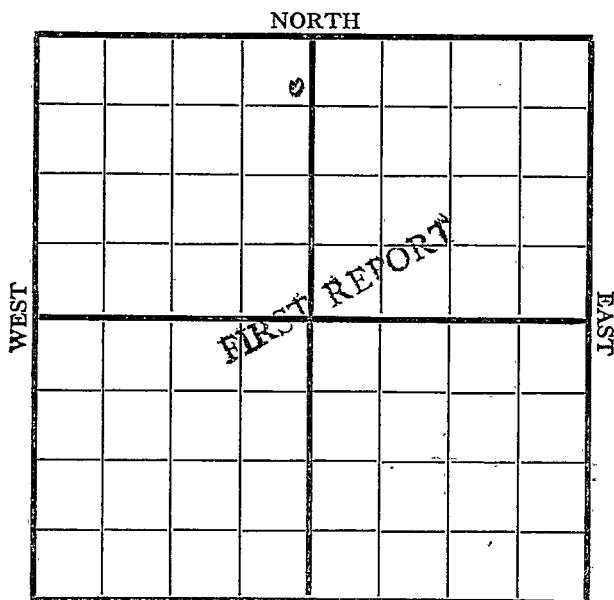

460 N SOUTH 200 E

Location ☒

Rig up _____

Drilling and Remarks:

RECORD

Cased _____ in., _____ ft.

Sand _____

Gas _____

Oil _____

Total Depth _____

PRODUCTION

1st 24 hrs. Nat. _____

1st 24 hrs. after shot _____

Gas _____ Cu. Ft.

Dry Hole _____

Abandoned _____

Date

7/19


1919

Pye

Scout

Map No. R 14 Sec. 18 Twp. 25 R. 6
 Well No. 1 Hazlett Block # 2
Gypsum Oil Company _____
 Contractor _____

NORTH

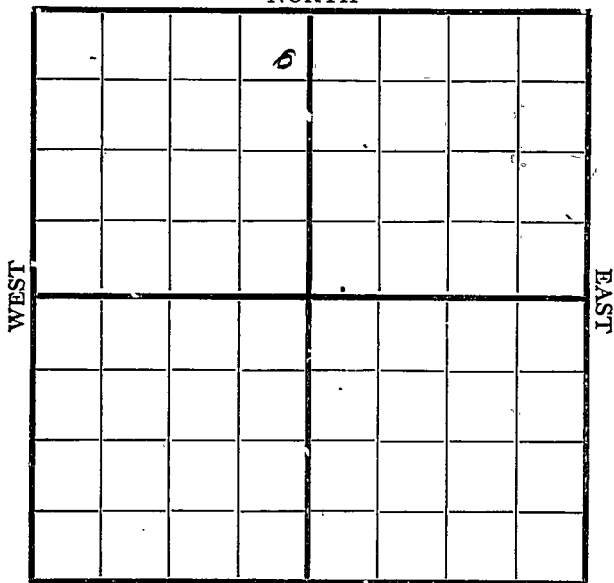

400 N

SOUTH

200 E

Location _____

Rig up _____

Drilling and Remarks:

R. O. M.

RECORD

Cased _____ in., _____ ft.

Sand _____

Gas _____

Oil _____

Total Depth _____

PRODUCTION

1st 24 hrs. Nat. _____

1st 24 hrs. after shot _____

Gas _____ Cu. Ft.

Dry Hole _____

Abandoned _____


Date

7/18 1919 Gyle Scout

Map No. K14 Sec. 18 Twp. 25 R. 6
 Well No. 1 Sanlett Blk. #2
Super Oil Company
 Contractor

NORTH

WEST

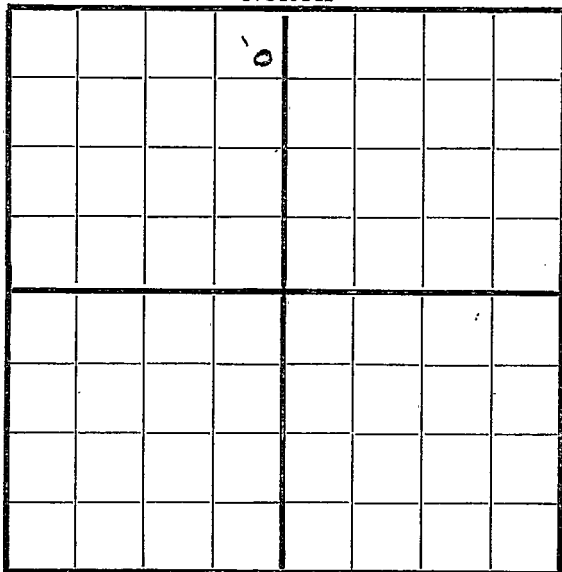

EAST

SOUTH

H60N

200E

Location ✓

Rig up

Drilling and Remarks:

RECORD

Cased _____ in., _____ ft.

Sand _____

Gas _____

Oil _____

Total Depth _____

PRODUCTION

1st 24 hrs. Nat. _____

1st 24 hrs. after shot _____

Gas _____ Cu. Ft.

Dry Hole _____

Abandoned _____

Date


7/24 1919 Pyh Scout

Map No. 1514 Sec. 18 Twp. 25 R. 6
 Well No. 1 Hazlett Block # 2
Lyfey Oil Company
 Contractor

NORTH

WEST

EAST

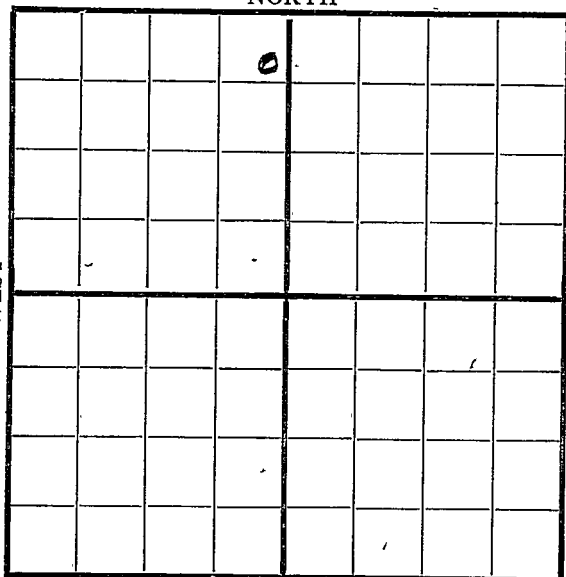

460 N

SOUTH

200 E

Location _____

Rig up ☒

Drilling and Remarks:

RECORD

Cased _____ in., _____ ft.

Sand _____

Gas _____

Oil _____

Total Depth _____

PRODUCTION

1st 24 hrs. Nat. _____

1st 24 hrs. after shot _____

Gas _____ Cu. Ft.

Dry Hole _____


Abandoned _____

Date

87 191 9 Cy. G. Scout
12

Map No. K14 Sec. 18 Twp. 25 R. 6
 Well No. 1 Haystack Blk #2
Haystack Oil Company
 Contractor

NORTH

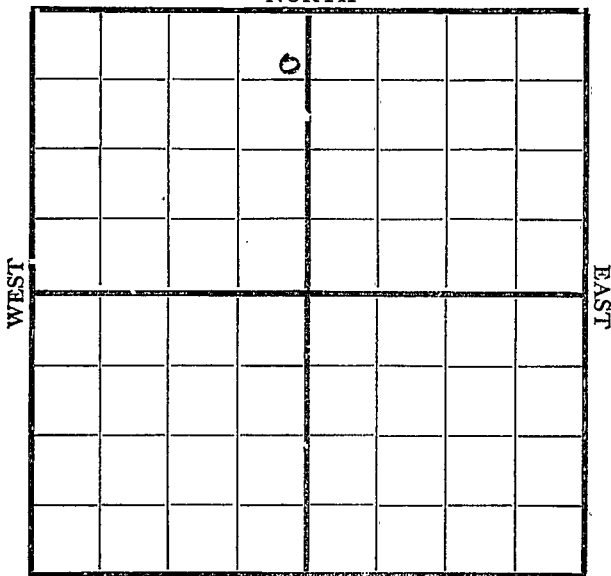

SOUTH

200 E

Location _____

Rig up ☒ _____

Drilling and Remarks:

RECORD

Cased _____ in., _____ ft.

Sand _____

Gas _____

Oil _____

Total Depth _____

PRODUCTION

1st 24 hrs. Nat. _____

1st 24 hrs. after shot _____

Gas _____ Cu. Ft.

Dry Hole _____

Abandoned _____

Date


7/6 191 9 Oy Co Scout

Map No. K 14 Sec. 18 Twp. 25 R. 6
 Well No. 1 Haylett Blk #2
Gypsum Oil Company
 Contractor

NORTH

WEST

EAST

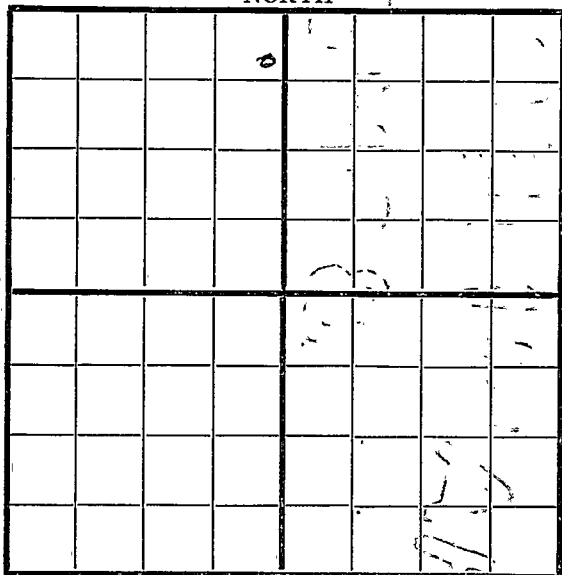

SOUTH

460 N

200 E

Location _____

Rig up ☒

Drilling and Remarks:

RECORD

Cased _____ in., _____ ft.

Sand _____

Gas _____

Oil _____

Total Depth _____

PRODUCTION

1st 24 hrs. Nat. _____

1st 24 hrs. after shot _____

Gas _____ Cu. Ft.

Dry Hole _____

Abandoned _____

Date

8
14

1919


Pyle

Scout

Sec. 18 Twp. 25 Rge. 6
 Owner Lynsey Oil
 Farm Hazlet Blk 2 Well No. 1
 Contractor _____

Feet from lines, N. 460 E. 200 S. _____ W. _____

Casing used _____
 15½ _____ ft.
 12½ _____ ft.
 10 _____ ft.
 8¼ _____ ft.
 6⅝ _____ ft.
 5 3-16 _____ ft.

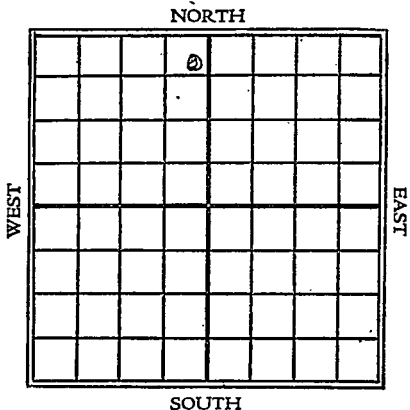

Location _____
 Rig _____

Drilling at _____ ft. Fishing at _____ ft.
 Total Depth _____ Completed _____
 1st 24 Hrs. Nat. _____ Producing _____
 1st 24 Hrs. Shot _____ Dry Hole _____
 Gas _____ Cu. ft. Abandoned _____
 Sands — give name and depth. Top _____ Bottom _____

Spud

Date of Report 8/20
 Reported by Pyle

Map No. K14 Sec. 18 Twp. 25 R. 6Well No. 1 Harlett Blk #2Lysay Oil Company

Contractor

SECTION PLAT

460 Ft. from N. Line

Ft. from S. Line

200 Ft. from E. Line

Ft. from W. Line

	0		

Location

Rig up

Drilling and Remarks:

300

RECORD

Cased _____ in., _____ ft.

Sand _____

Gas _____

Oil _____

Total Depth _____

PRODUCTION

1st 24 hrs. Nat. _____

1st 24 hrs. after shot _____

Gas _____ Cu. Ft.

Dry Hole _____

Abandoned _____

Date

8/29 1919Pyle Scout

Map No. K 14 Sec. 18 Twp. 25 R. 6
 Well No. Haylett Blk # 2
Lipsey Oil Company
 Contractor

SECTION PLAT

460 Ft. from N. Line

_____ Ft. from S. Line

200 Ft. from E. Line

_____ Ft. from W. Line

	0		

Location _____

Rig up _____

Drilling and Remarks:

RECORD

Cased _____ in., _____ ft.

Sand _____

Gas _____

Oil _____

Total Depth _____

PRODUCTION

1st 24 hrs. Nat. _____

1st 24 hrs. after shot _____

Gas _____ Cu. Ft.

Dry Hole _____

Abandoned _____

Date

9/4 1919 Pyle Scout

Map No. K14 Sec. 18 Twp. 25 R. 6Well No. 1 Hazlett Blk #2Gypsy Oil Company

Contractor

SECTION PLAT

460 Ft. from N. Line

Ft. from S. Line

200 Ft. from E. Line

Ft. from W. Line

	6		

Location

Rig up

Drilling and Remarks:

805'

RECORD

Cased _____ in., _____ ft.

Sand _____

Gas _____

Oil _____

Total Depth _____

PRODUCTION

1st 24 hrs. Nat. _____

1st 24 hrs. after shot _____

Gas _____ Cu. Ft.

Dry Hole _____

Abandoned _____

Date

9/14 1919Pyle Scout

Map No. K 14 Sec. 18 Twp. 25 R. 6
 Well No. 1 Hazlett Blk #2
Gypsy Oil Company
 Contractor

SECTION PLAT

460 Ft. from N. Line

_____ Ft. from S. Line

200 Ft. from E. Line

_____ Ft. from W. Line

	o		

Location _____

Rig up _____

Drilling and Remarks:

901'

RECORD

Cased _____ in., _____ ft.

Sand _____

Gas _____

Oil _____

Total Depth _____

PRODUCTION

1st 24 hrs. Nat. _____

1st 24 hrs. after shot _____

Gas _____ Cu. Ft.

Dry Hole _____

Abandoned _____

Date

Pyle

9/ 1919

Scout

20

Map No. K 14 Sec. 18 Twp. 25 R. 6Well No. 1 Hazlett Blk # 2Lyfsey Oil Company

Contractor

SECTION PLAT

460 Ft. from N. Line

----- Ft. from S. Line

200 Ft. from E. Line

----- Ft. from W. Line

	0		

Location -----

Rig up -----

Drilling and Remarks:

RECORD

Cased ----- in., ----- ft.

Sand -----

Gas -----

Oil -----

Total Depth -----

PRODUCTION

1st 24 hrs. Nat. -----

1st 24 hrs. after shot -----

Gas ----- Cu. Ft.

Dry Hole -----

Abandoned -----

Date

9/26 1919

Pyl

Scout

Map No. K14 Sec. 18 Twp. 25 R. 6Well No. 1 Haylett BlkHwy Oil Company

Contractor

SECTION PLAT

460 Ft. from N. Line

Ft. from S. Line

200 Ft. from E. Line

Ft. from W. Line

	0		

Location

Rig up

Drilling and Remarks:

1200'

RECORD

Cased _____ in., _____ ft.

Sand _____

Gas _____

Oil _____

Total Depth _____

PRODUCTION

1st 24 hrs. Nat. _____

1st 24 hrs. after shot _____

Gas _____ Cu. Ft.

Dry Hole _____

Abandoned _____

Date

10/4 1919

Pyle

Scout

Map No. K14 Sec. 18 Twp. 25 R. 6Well No. 1 HazlettBy pay Oil Company

Contractor

1803


SECTION PLAT

460 Ft. from N. Line

Ft. from S. Line

200 Ft. from E. Line

Ft. from W. Line

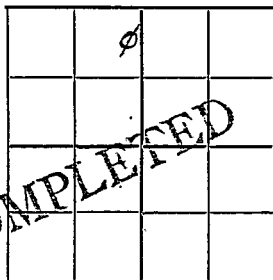

Location

Rig up

Drilling and Remarks:

RECORD

Cased _____ in., _____ ft.

Sand _____

Gas _____

Oil _____

Total Depth _____

PRODUCTION

1st 24 hrs. Nat. _____

1st 24 hrs. after shot _____

Gas _____ / Cu. Ft.

Dry Hole 2515

Abandoned _____

Date

1/6 1919Pyle Scout