FORM 51 10M 8-47

Butler


KANSAS

Section 23 Township 25 Range 6E

Well No. #1 Brown "A"

Company Shell

Wildcat

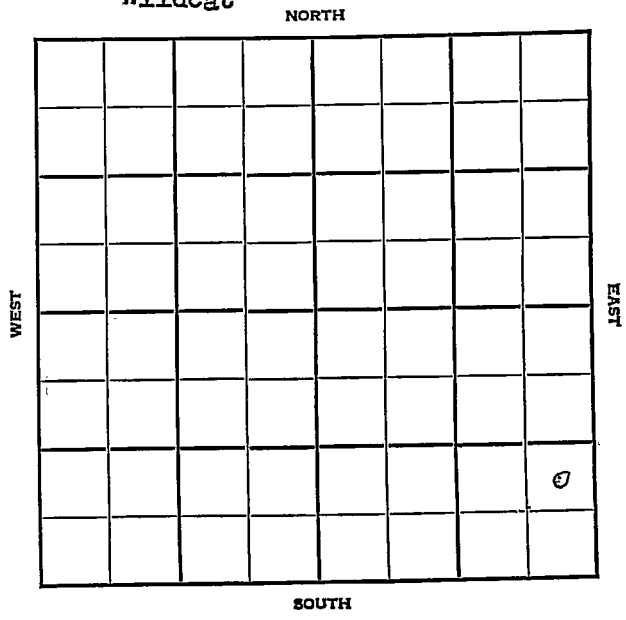

FORM 252-A
5M 12-45 PETROL

KANSAS Butler ✓

Sec. 23 Twp. 25 R. 6E

Well No. #1 Brown "A" Farm

Shell Company
Wildcat


____ Ft. from N. Line

990 Ft. from S. Line

330 Ft. from E. Line

____ Ft. from W. Line

NE SE SE

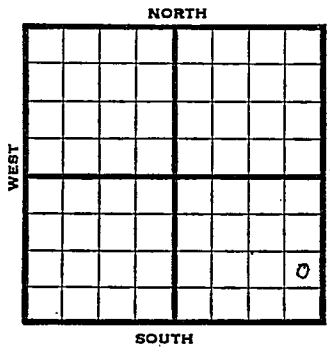

1948	Elev. 1384' REPORT
4/7	8" @ 58' WOC
4/14	Drlg. 2210'
4/21	TD 2795' ABANDONED
9/22	Lans. 1794' KC 2086' Bart 2650' Miss 2780' TD 2795' D&A Abd. 4/21/48 2nd Abd. ABANDONED

Form 26—200 Bks.—1-48—Palace

Wildcat

Kansas

Map No. _____ Sec. 23 Twp. 25 R. 6E


Well No. 1 Brown "A"

Shell Company

FIRST REPORT Contractor

NE SE SE

SECTION PLAT

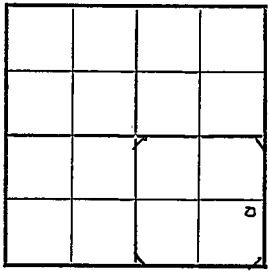

_____ Ft. from N. Line

990 Ft. from S. Line

330 Ft. from E. Line

_____ Ft. from W. Line

Butler County

Location _____

Rig up _____

Drilling and Remarks:

8" @ 58' WOC

RECORD

Cased _____ in., _____ ft.

Sand _____

Gas _____

Oil _____

Total Depth _____

PRODUCTION

1st 24 hrs. Nat. _____

1st 24 hrs. after shot _____

Gas _____ Cu. Ft.

Dry Hole _____

Abandoned _____

Date

APR 7 1948 19 S. J. LEWIS Scout

Form 26—200 Bks.—1-48—Palace

Wildcat

Kansas

Map No. 14 Sec. 23 Twp. 25 R. 6E

Well No. 1 Brown "A"


Shell Company

ABANDONED Contractor

NE SE SE

E-11384

SECTION PLAT

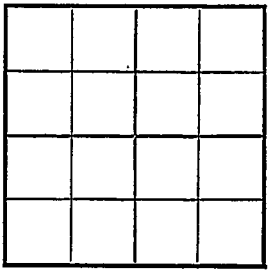

____ Ft. from N. Line

990 Ft. from S. Line

330 Ft. from E. Line

____ Ft. from W. Line

Butler County

Location

Rig up

Drilling and Remarks:

RECORD

Cased ____ in., ____ ft.

Sand

Gas

Oil

Total Depth 2795

PRODUCTION

1st 24 hrs. Nat.

1st 24 hrs. after shot

Gas ____ Cu. Ft.

Dry Hole

Abandoned

Date

APR 21 1948 19____ S. J. LEWIS Scout

Form 27—100 Bks.—4-48—Petrol

Butler County Kansas State

Map No. 14 Sec. 23 Twp. 25 R. 6E

Well No. 1 Brown "A"


Shell Company

ABANDONED Contractor

NE SE SE

E.1884

SECTION PLAT

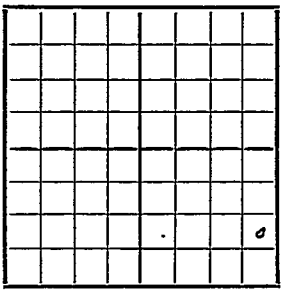

____ Ft. from N. Line

990 Ft. from S. Line

330 Ft. from E. Line

____ Ft. from W. Line

Wildcat

Remarks:

Lans. 1794 KC 2086 Bart. 2650

Miss. 2780 TD 2795 D & A

Abd. 4/21/48

Date SEP 2 2 1948

Scout S. J. LEWIS