


Butler

Map No. _____ Sec. 23 Twp. 25 R. 6

Well No. 1-Clayton Farm
Haworth & Howard Company

NORTH

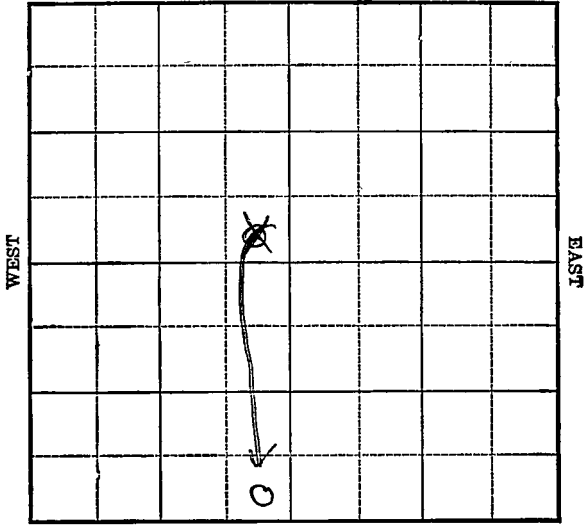

SOUTH

Location _____

Drilling Remarks _____

Rig Up _____

Drilling Remarks _____

RECORD

Cased _____ in. _____ ft.

Sand _____

Gas _____

Oil _____

Total Depth _____

PRODUCTION

1st 24 hrs. Nat. _____

1st 24 hrs. after shot _____

Gas _____ cu. ft.

Dry Hole _____

Abandoned _____

Butler

Map No. _____ Sec. 23 Twp. 25 R. 6


Well No. 1 - Clopton Farm
Haworth & Howard Company

_____ Ft. from N. Line

330 Ft. from S. Line

330 Ft. from E. Line

_____ Ft. from W. Line

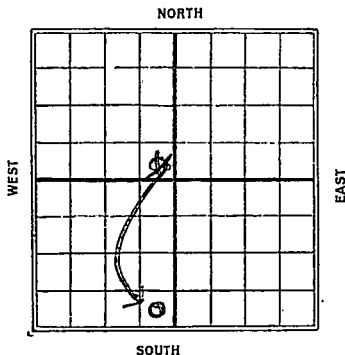

1927

Date	REPORT
3/24	Location
3/30	_____
4/7	_____
4/13	_____
4/20	_____
4/27	_____
5/5	_____
5/12	_____
5/18	Spudding
5/25	Drlg 400
6/1	" 750
6/7	" 1615
6/15	" 2340
6/22	" 2713
6/29	Repairing rig - T.D. 2720.
7/13	Top lined 2754'
	D.O.A. 2820'
	T.D. 2820'
	D.O.A.

Butler

14 KANSAS

Map No. _____ Sec. *23* Twp. *25* R. *6*

Well No. *1 Clayton*

Haworth & Howard

Company

Contractor

FIRST REPORTS

SECTION PLAT

_____ Ft. from N. Line

330

_____ Ft. from S. Line

330

_____ Ft. from E. Line

_____ Ft. from W. Line

	0		

Location _____

Rig up _____

Drilling and Remarks:

RECORD

Cased _____ in., _____ ft.

Sand _____

Gas _____

Oil _____

Total Depth _____

PRODUCTION

1st 24 hrs. Nat. _____

1st 24 hrs. after shot _____

Gas _____ Cu. Ft.

Dry Hole _____

Abandoned _____

Date

MAR 24 1927

CHAS. L. SHERWOOD

192

Scout

14 KANSAS *Butter*
Map No. _____ Sec. *23* Twp. *25* R. *6*
Well No. *1* *Clayton*
Haworth L. Howards Company

Contractor

CORRECTION

SECTION PLAT

_____ Ft. from N. Line

330 Ft. from S. Line

330 Ft. from E. Line

_____ Ft. from W. Line

Location

Rig up _____

Drilling and Remarks:

By location

RECORD

Cased _____ in., _____ ft.

Sand _____

Gas _____

Oil _____

Total Depth _____

PRODUCTION

1st 24 hrs. Nat. _____

1st 24 hrs. after shot _____

Gas _____ Cu. Ft.

Dry Hole _____

Abandoned _____

Date

APR 13 1927

CHAS. L. SHERWOOD

Scout

14 KANSAS
Map No. _____ Sec. ²³ Twp. ²⁵ R. ⁶

Well No. ¹ Clayton

Haworth & Howard Company

Contractor

COMPLETED

SECTION PLAT

_____ Ft. from N. Line

330 Ft. from S. Line

330 Ft. from E. Line

_____ Ft. from W. Line

ABANDONED

Location _____

Rig up _____

Drilling and Remarks:

Top line 2754'

27 2820

RECORD

Cased _____ in., _____ ft.

Sand _____

Gas _____

Oil _____

Total Depth 2820'

PRODUCTION

1st 24 hrs. Nat. _____

1st 24 hrs. after shot _____

Gas _____ Cu. Ft.

Dry Hole

Abandoned

Date

July 13 1927

CHAS. L. SHERWOOD

Scout