

KANSAS


Butler

Section 24 Township 25 Range 6E

Well No. #1 Brown

Company Shell

Wildcat

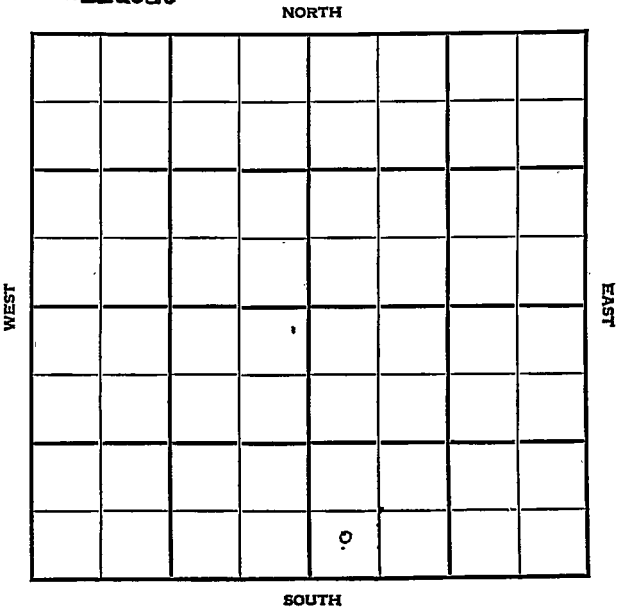

KAN

Butler

Sec. 24 Twp. 25 R. 6E ✓

Well No. #1 Brown Farm

Shell Company

Wildcat


 Ft. from N. Line

380' Ft. from S. Line

 Ft. from E. Line

330' Ft. from W. Line

SW SE

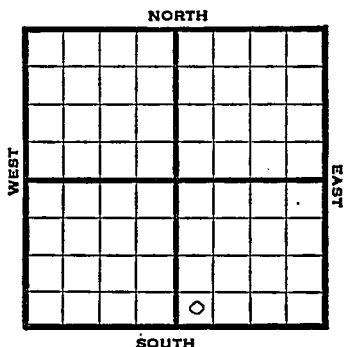

1948

Elev. 1372' REPORT

3/24 Drlg. 150'

3/31 Drlg. 2320'

4/7 TD 2784'

ABANDONED

9/22

Lans. 1767'

KC 2069'

Bart 2661'

Miss 2755'

TD 2784'

D&A

Abd 4/7/48

2nd Abd.

ABANDONED

Map No. _____ Sec. 24 Twp. 25 R. 6E

Well No. 1 Brown

Shell _____ Company

FIRST REPORT _____ Contractor

SW SE


SECTION PLAT

_____ Ft. from N. Line

380 Ft. from S. Line

_____ Ft. from E. Line

330 Ft. from W. Line

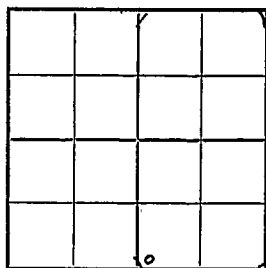

Butler County

Location _____

Rig up _____

Drilling and Remarks:

drlg. 150

RECORD

Cased _____ in., _____ ft.

Sand _____

Gas _____

Oil _____

Total Depth _____

PRODUCTION

1st 24 hrs. Nat. _____

1st 24 hrs. after shot _____

Gas _____ Cu. Ft.

Dry Hole _____

Abandoned _____

Date

MAR 24 1948 19 _____ S. J. LEWIS Scout

Map No. 14 Sec. 24 Twp. 25 R. 6E

Well No. 1 Brown

Shell Company

ABANDONED Contractor

SW SE


SECTION PLAT

 Ft. from N. Line

380 Ft. from S. Line

 Ft. from E. Line

330 Ft. from W. Line

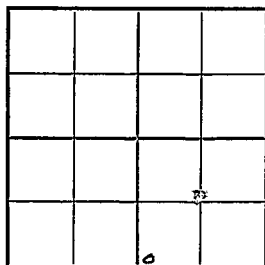

Butler County

Location

Rig up

Drilling and Remarks:

RECORD

Cased in., ft.

Sand

Gas

Oil

Total Depth 2784

PRODUCTION

1st 24 hrs. Nat.

1st 24 hrs. after shot

Gas Cu. Ft.

Dry Hole

Abandoned

Date

APR 7 1948 19 S. J. LEWIS Scout

