


Section 26 Township 25 Range 6E

Well No. #1 Matlock

Company Shell

Wildcat

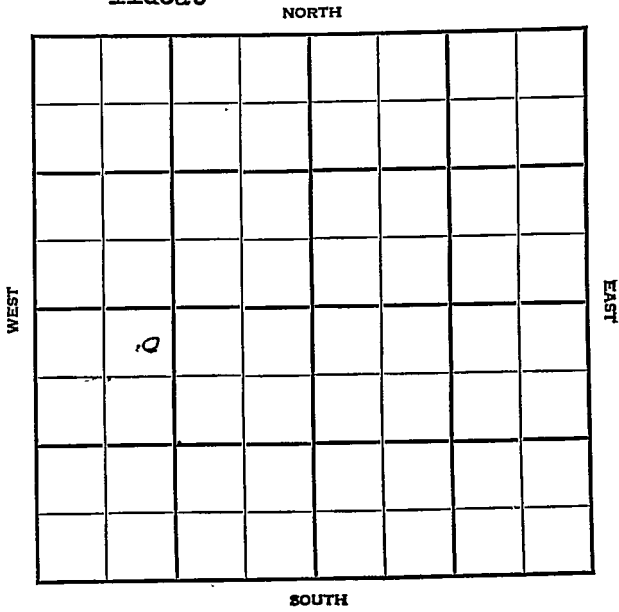



Sec. 26 Twp. 25 R. 6E

Well No. #1 Matlock Farm

Shell Company

Wildcat


W

330 Ft. from N. Line

Ft. from S. Line

Ft. from E. Line

1007 Ft. from W. Line

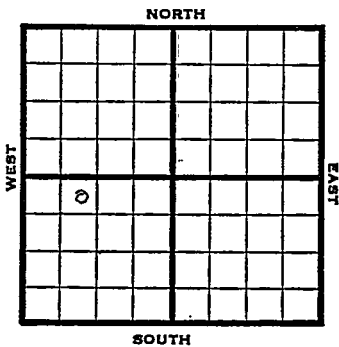

NE NW SW

1948

Elev. 1344' REPORT

4/14

Location

4/21

8" @ 69'
Drlg. 1058'

4/28

Drlg. 2693'

5/5

TD 2745'
~~ABANDONED~~
ABANDONED

9/22

Lans. 1760' KC 2055'
Bart 2713' Miss 2730'
TD 2745'
D&A
Abd 5/5/48
2nd Abd.

ABANDONED

Map No. _____ Sec. 26 Twp. 25 R. 6E

Well No. 1 Matlock

Shell Company

FIRST REPORT

Contractor _____

NE NW SW

SECTION PLAT

330 Ft. from N. Line

_____ Ft. from S. Line

_____ Ft. from E. Line

1007 Ft. from W. Line

o			

Butler County

Location X

Rig up _____

Drilling and Remarks:

RECORD

Cased _____ in., _____ ft.

Sand _____

Gas _____

Oil _____

Total Depth _____

PRODUCTION

1st 24 hrs. Nat. _____

1st 24 hrs. after shot _____

Gas _____ Cu. Ft.

Dry Hole _____

Abandoned _____

Date

APR 14 1948 19

S. J. LEWIS Scout

Map No. 14 Sec. 26 Twp. 25 R. 6E

Well No. 1 Matlock

Shell Company

ABANDONED

Contractor

NE NW SW

E 11344
SECTION PLAT

330 Ft. from N. Line

_____ Ft. from S. Line

_____ Ft. from E. Line

1007 Ft. from W. Line

o			

Butler County

Location _____

Rig up _____

Drilling and Remarks:

RECORD

Cased _____ in., _____ ft.

Sand _____

Gas _____

Oil _____

Total Depth 1594.5

PRODUCTION

1st 24 hrs. Nat. _____

1st 24 hrs. after shot _____

Gas _____ Cu. Ft.

Dry Hole _____

Abandoned _____

Date

MAY 5 1948 19

S. J. LEWIS Scout

Butler County Kansas State

Map No. 14 Sec. 26 Twp. 25 R. 6E

Well No. 1 Matlock

Shell Company

ABANDONED

Contractor

NE NW SW

E 11344

SECTION PLAT

330 Ft. from N. Line

 Ft. from S. Line

 Ft. from E. Line

1007 Ft. from W. Line

Wildcat

Remarks:

Lans. 1760 KC 2055 Bart. 2713

Miss. 2730 TD 2745 D & A

abd. 5/5/48

Date
SEP 22 1948

Scout S. J. LEWIS