

Butler

FORM 51 25M 3-49 PETROL


KANSAS

Section 33 Township 25 Range 6E

Well No. #1 Koble

Company Scanlon et al

NORTH

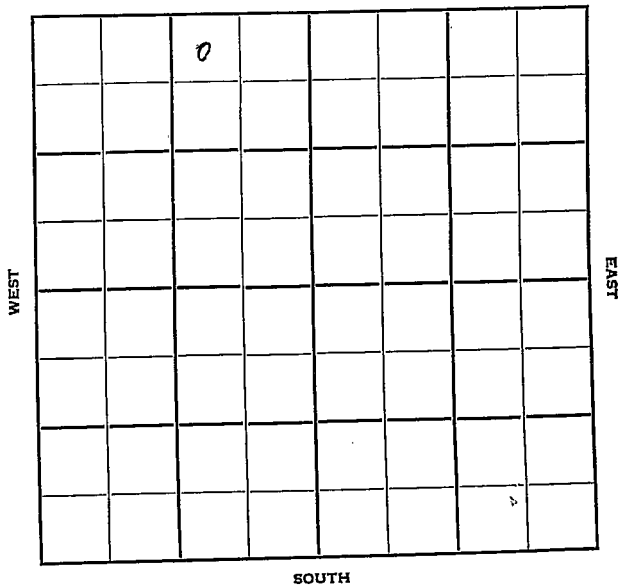

SOUTH

Butler

KANSAS
6E

Sec. 33 Twp. 25 R.


Well No. #1 Koble Farm

Scanlon et al Company

Wildcat

NORTH

330' Ft. from N. Line

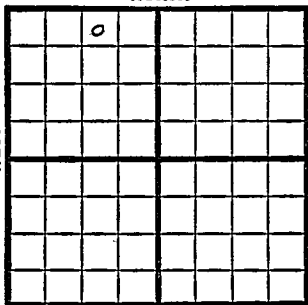

 Ft. from S. Line

990' Ft. from E. Line

 Ft. from W. Line

NW NE NW

SOUTH

1950 Elev. 1368' REPORT

1/18 RUR

2/22
 13" @ 1020'
 10" @ 1643'
 7" @ 2430'
 Lans 1805'
 Barts 2640'
 Miss 2780'
 D&A
 TD 2801'
ABANDONED

Kansas

Wildcat

Map No. _____ Sec. 33 Twp. 25 R. 6EWell No. 1 KobleScanlon etal. Company

Contractor

NW NE NW

SECTION PLAT

330 Ft. from N. Line

_____ Ft. from S. Line

990 Ft. from E. Line

_____ Ft. from W. Line

	o		
FIRST REPORT			

Butler County

Location _____

Rig up _____

Drilling and Remarks:

R U R

RECORD

Cased _____ in., _____ ft.

Sand _____

Gas _____

Oil _____

Total Depth _____

PRODUCTION

1st 24 hrs. Nat. _____

1st 24 hrs. after shot _____

Gas _____ Cu. Ft.

Dry Hole _____

Abandoned _____

Date

JAN 18 1950 19J. E. TYR Scout

Kansas

Map No. _____ Sec. 33 Twp. 25 R. 6E

Well No. 1 Koble

Scanlon etal. Company

Contractor

NW NE NW

E1. 1368
SECTION PLAT

330 Ft. from N. Line

_____ Ft. from S. Line

990 Ft. from E. Line

~~990~~ ⁵¹² Ft. from W. Line

	0		
ABANDONED			

Butler County

Location _____

Rig up _____

Drilling and Remarks:

13" @ 1020
10" @ 1643
7" @ 2430
Lans 1805
Borts 2640
Miss 2780

D & A

RECORD

Cased _____ in., _____ ft.

Sand _____

Gas _____

Oil _____

Total Depth 2801

PRODUCTION

1st 24 hrs. Nat. _____

1st 24 hrs. after shot _____

Gas _____ Cu. Ft.

Dry Hole _____

Abandoned _____

Date

FEB 22 1950

19

J. E. TYRA

Scout