


Section 34 Township 25 Range 6-E

Well No. #1 Elmore

Company Nadel & Gussman

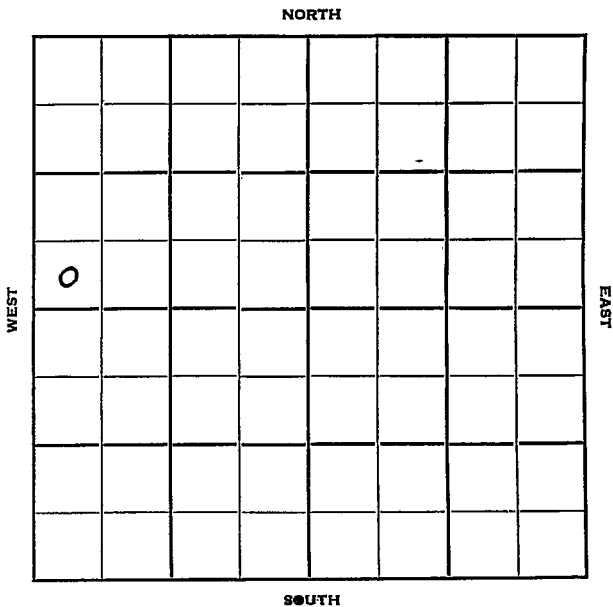

Butler  
25

KANSAS 6E ✓  
R.

Sec. 34 Twp. R.

Well No. #1 Elmore Farm

Nadel & Gussman Company

Rex & Morris - Contr. Contractor

Wildcat


Ft. from N. Line

330' Ft. from S. Line

Ft. from E. Line

330' Ft. from W. Line

SW SW NW

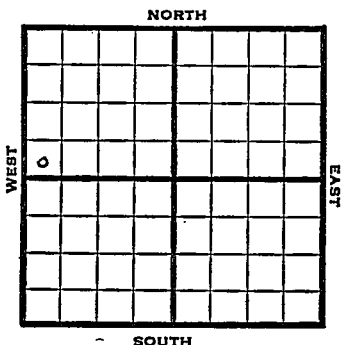

1950

Elev 1386'

REPORT

11/15

RUR

12/20

Spud 11-20-50

15" @ 150

13" @ 870

10" @ 1440

Miss 2776-86 TD

TD 2786'

D&A

**ABANDONED**

County Butler State Kansas

Sec. 34 (Blk. Twp.) 25 (Sur. Rge.) 6E Map No.

Operator Nadel & Gussman

Well No. 1 Farm Elmore

Elev. \_\_\_\_\_ Location SW SW NW


330 Ft. From S Line NW

330 Ft. From W Line Quarter

1st. Report NOV 15 1950

Completion \_\_\_\_\_

Remarks \_\_\_\_\_

Rex & Morris - Contr.

Spudding Date \_\_\_\_\_

Drlg. Data Wildcat

RUR

