


Section 35 Township 25 Range 6-E

Well No. #1 Mueller

Company Shell

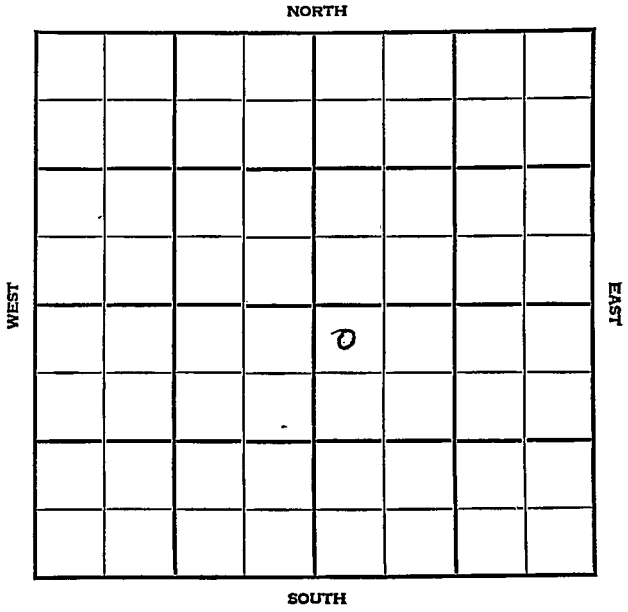

Butler



KANSAS

Sec. 35 Twp. 25 R. 1E

Well No. #1 Mueller Farm

Shell Company

Wildcat


330' Ft. from N. Line

Ft. from S. Line

Ft. from E. Line

330' Ft. from W. Line

NW SE

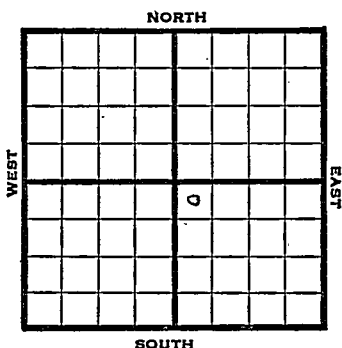

1948

Elev. 1413' REPORT

5/5 Location

5/12 8" @ 64'

5/19 Drlg. 2360'

5/26 TD 2768'

**ABANDONED**

9/22 Lans. 1780'

Bart 2677'

TD 2768'

D&A

Abd 5/12/48

2nd Abd.

**ABANDONED**

KC 2100'

Miss 2760'

Wildcat

Form 26—200 Bks.—1-48—Palace  
Kansas

Map No. \_\_\_\_\_ Sec. 35 Twp. 25 R. 6E

Well No. 1 Mueller

Shell Company

FIRST REPORT

Contractor

NW SE

SECTION PLAT

330 Ft. from N. Line

\_\_\_\_\_ Ft. from S. Line

\_\_\_\_\_ Ft. from E. Line

330 Ft. from W. Line

|  |  |   |  |
|--|--|---|--|
|  |  |   |  |
|  |  |   |  |
|  |  | o |  |
|  |  |   |  |

Butler County

Location X

Rig up \_\_\_\_\_

Drilling and Remarks:

RECORD

Cased \_\_\_\_\_ in., \_\_\_\_\_ ft.

Sand \_\_\_\_\_

Gas \_\_\_\_\_

Oil \_\_\_\_\_

Total Depth \_\_\_\_\_

PRODUCTION

1st 24 hrs. Nat. \_\_\_\_\_

1st 24 hrs. after shot \_\_\_\_\_

Gas \_\_\_\_\_ Cu. Ft.

Dry Hole \_\_\_\_\_

Abandoned \_\_\_\_\_

Date

MAY 5 1948 19

S. J. LEWIS

Scout

Map No. 14 Sec. 35 Twp. 25 R. 6E

Well No. 1 Mueller

Shell Company

**ABANDONED** Contractor

NW SE

*E. 1413*  
SECTION PLAT

330 Ft. from N. Line

\_\_\_\_\_ Ft. from S. Line

\_\_\_\_\_ Ft. from E. Line

330 Ft. from W. Line

|  |  |  |  |
|--|--|--|--|
|  |  |  |  |
|  |  |  |  |
|  |  |  |  |
|  |  |  |  |

Butler County

Location \_\_\_\_\_

Rig up \_\_\_\_\_

Drilling and Remarks:

RECORD

Cased \_\_\_\_\_ in., \_\_\_\_\_ ft.

Sand \_\_\_\_\_

Gas \_\_\_\_\_

Oil \_\_\_\_\_

Total Depth 2768

PRODUCTION

1st 24 hrs. Nat. \_\_\_\_\_

1st 24 hrs. after shot \_\_\_\_\_

Gas \_\_\_\_\_ Cu. Ft.

Dry Hole \_\_\_\_\_

Abandoned \_\_\_\_\_

Date

MAY 26 1948

19

S. J. LEWIS

Scout

Butler County Kansas State

Map No. 14 Sec. 35 Twp. 25 R. 6E

Well No. 1 Mueller

Shell Company

**ABANDONED**

Contractor

NW SE

*E. J. LEWIS*

**SECTION PLAT**

330 Ft. from N. Line

       Ft. from S. Line

       Ft. from E. Line

330 Ft. from W. Line

|  |  |  |  |  |   |  |  |
|--|--|--|--|--|---|--|--|
|  |  |  |  |  |   |  |  |
|  |  |  |  |  |   |  |  |
|  |  |  |  |  |   |  |  |
|  |  |  |  |  | 0 |  |  |
|  |  |  |  |  |   |  |  |
|  |  |  |  |  |   |  |  |
|  |  |  |  |  |   |  |  |
|  |  |  |  |  |   |  |  |

Wildcat  
Remarks:

Lans. 1780    KC 2100    Bart. 2677  
Miss. 2760    TD 2768    D & A  
abd. 5/12/48

Date  
SEP 22 1948

Scout **S. J. LEWIS**