

Ellsworth KANSAS

FORM 51 IOM 12-46 PETROL

Section 34 Township 16 Range 10W

Well No. 5 Matosh "A"

Company Atlantic et al  
Stoltenberg Pool

NORTH


10

WEST

EAST

SOUTH

Sec. 34 Twp. 16 R. 10-W

Well No. #5 Matosh "A" Farm


Atlantic etal  
Stoltenberg Pool Company

330 Ft. from N. Line

\_\_\_\_\_ Ft. from S. Line

\_\_\_\_\_ Ft. from E. Line

330 Ft. from W. Line

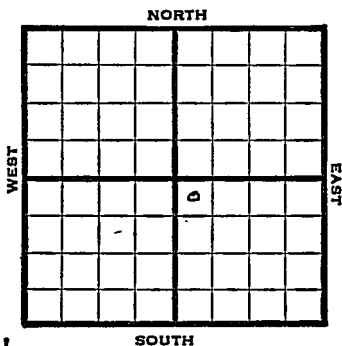

NW SE Elev. 1816'

REPORT

1947

3/19 RUR

3/25 8" @ 384'  
WOC

4/2 Drlg. 2854'

4/9 Lans 2954  
BKC 3175  
Arb 3259  
TD 3264'  
5" @ 3264'  
RUST

4/15 TD 3270'  
3000 Acid  
Swb 20 bbls. oil & 1W PH 8 hrs.

4/23 " " "

4/29 " " "

5/79 " " "

5/14 Arb. 3259'  
5" @ 3264'  
3000 Acid  
Pump 422 Pot  
42.4 Gr.  
TD 3270'

**COMPLETED**

Map No. 55 Sec. 34 Twp. 16 R. 10W

Well No. 5 Matosh "A"

Atlantic etal. Company

**FIRST REPORT** Contractor

NW SE

SECTION PLAT

330 Ft. from N. Line

\_\_\_\_\_ Ft. from S. Line

\_\_\_\_\_ Ft. from E. Line

330 Ft. from W. Line

		o	

Ellsworth County

Location \_\_\_\_\_

Rig up \_\_\_\_\_

Drilling and Remarks:

R U R

RECORD

Cased \_\_\_\_\_ in., \_\_\_\_\_ ft.

Sand \_\_\_\_\_

Gas \_\_\_\_\_

Oil \_\_\_\_\_

Total Depth \_\_\_\_\_

PRODUCTION

1st 24 hrs. Nat. \_\_\_\_\_

1st 24 hrs. after shot \_\_\_\_\_

Gas \_\_\_\_\_ Cu. Ft.

Dry Hole \_\_\_\_\_

Abandoned \_\_\_\_\_

Date

MAR 19 1947 19

S. J. LEWIS Scout

Map No. K 55 Sec. 34 Twp. 16 R. 10<sup>W</sup>

Well No. 5 Matosh "A"

Atlantic etal. Company

**COMPLETE**

Contractor

NW SE

*E 11876*  
**SECTION PLAT**

330 Ft. from N. Line

\_\_\_\_\_ Ft. from S. Line

\_\_\_\_\_ Ft. from E. Line

330 Ft. from W. Line

		0	

**Ellsworth County**

Location \_\_\_\_\_

Rig up \_\_\_\_\_

Drilling and Remarks:

*Core 13257*

*5" @ 3264*

*3000 acid*

*Pump 422 P.J.*

*H. J. L.*

**RECORD**

Cased \_\_\_\_\_ in., \_\_\_\_\_ ft.

Sand \_\_\_\_\_

Gas \_\_\_\_\_

Oil \_\_\_\_\_

Total Depth 3270

**PRODUCTION**

1st 24 hrs. Nat. \_\_\_\_\_

1st 24 hrs. after shot \_\_\_\_\_

Gas \_\_\_\_\_ Cu. Ft.

Dry Hole \_\_\_\_\_

Abandoned \_\_\_\_\_

Date

MAY 14 1947

19

S. J. LEWIS

Scout