


KANSAS Ellsworth county
Stoltenberg

Section 34 Township 16 Range 10W

Well No. 6 Matosh "A"

Company Atlantic et al

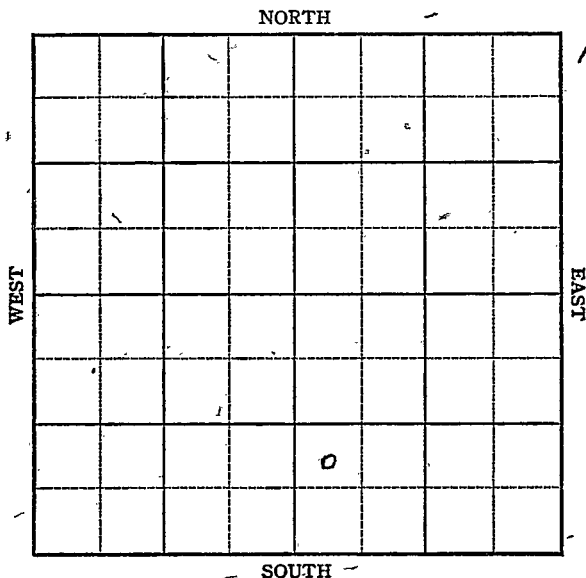

KANSAS

Ellsworth ✓

Sec. 34 Twp. 16 R. 10-W

Well No. #6 Matosh "A" Farm


Atlantic etal Company
Stoltenberg

 Ft. from N. Line

990 Ft. from S. Line

 Ft. from E. Line

330 Ft. from W. Line

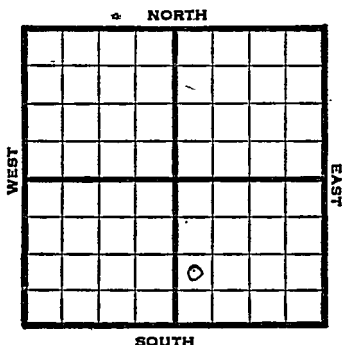

NW SW SE

1947

Elev. 1801' REPORT

4/16

RUR

4/23

8" @ 387'
WOC

4/29

Drlg 2830'

5/7

Arbuckle 3236
TD 3242'
5" @ 3239
RUST

5/13

TD 3253'
1500 Acid
Shot 13 bbls. oil PH 3 hrs.

5/20

" " "

5/27

TD 3253'

6/3

"

6/10

"

6/17

"

6/24

5000 acid

OVER

7/2

Arb. 3236'

5" @ 3239'

1500 Acid

Pump 429 Oil / 24% water Pot

42.0 Gr.

TD 3253'

COMPLETED

Map No. 155 Sec. 34 Twp. 16 R. 10W

Well No. 6 Matosh "A"

Atlantic etal. Company

FIRST REPORT Contractor

NW SW SE

SECTION PLAT

 Ft. from N. Line

990 Ft. from S. Line

 Ft. from E. Line

330 Ft. from W. Line

		o	

Ellsworth County

Location

Rig up

Drilling and Remarks:

R U R

RECORD

Cased in., ft.

Sand

Gas

Oil

Total Depth

PRODUCTION

1st 24 hrs. Nat.

1st 24 hrs. after shot

Gas Cu. Ft.

Dry Hole

Abandoned

Date

APR 16 1947 19

S. J. LEWIS

Scout

Kansas

Map No. 55 Sec. 34 Twp. 16 R. 10WWell No. 6 Matosh "A"

Atlantic etal:

Company

COMPLETE

Contractor

NW SW SE

E 1, 1801
SECTION PLAT Ft. from N. Line990 Ft. from S. Line Ft. from E. Line330 Ft. from W. Line

Ellsworth County

Location Rig up

Drilling and Remarks:


RECORD

Cased in., ft.Sand Gas Oil Total Depth 2258

PRODUCTION

1st 24 hrs. Nat. 1st 24 hrs. after shot Gas Cu. Ft.Dry Hole Abandoned

Date

JUL 2 1947 19

S. J. LEWIS Scout