


KANSAS

Ellsworth

Section 34 Township 16 Range 10W

Well No. #2 Matosh "B"

Company Atlantic

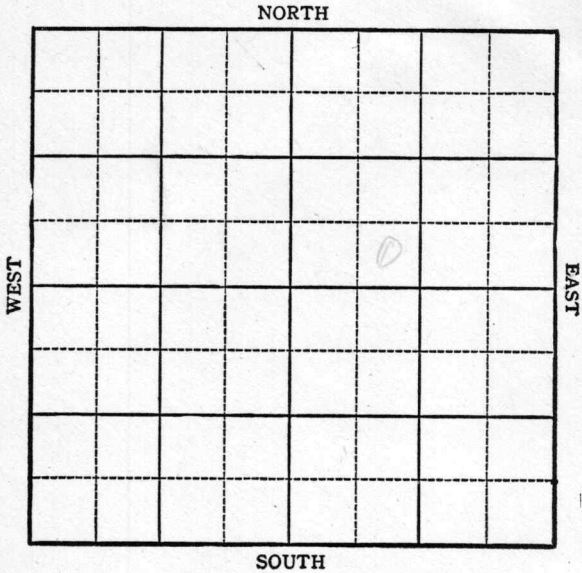

KANSAS

Sec. 34 Twp. 16 R. 10W

Well No. #2 Matosh "B" Farm

Atlantic Company

Stoltenberg


NORTH

_____ Ft. from N. Line

330 Ft. from S. Line

_____ Ft. from E. Line

990 Ft. from W. Line

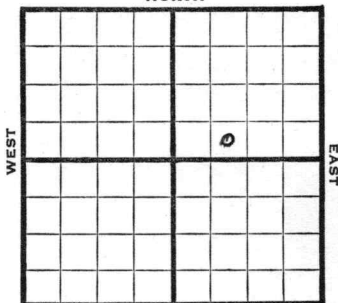

SOUTH

SE SW NE

1944

REPORT

8/16 Surface Hole
 8/23 8" @ 372
 Anhy 565
 Drlg. 2335
 8/30 Lans 2952
 Arb 3265
 TD 3270
 Sat
 5" @ 3266 RUST
 9/80 1500 acid
 9/13 TD 3273 swb 5 oil per hr 1500 acid
 9/20 Arb 3265
 5" @ 3266
 1500 acid
 Pump 307 oil plus 26% wtr Pot.
 TD 3273
 Grav. 42.4

COMPLETED

KANSAS

Pool Name Stoltenberg

Map No. 55 Sec. 34 Twp. 16 R. 10W

Well No. 2 Matosh "B"

Atlantic Company

FIRST REPORT Contractor

SE SW NE

SECTION PLAT

		o	

_____ Ft. from N. Line

330 Ft. from S. Line

_____ Ft. from E. Line

990 Ft. from W. Line

Ellsworth

Location _____

Rig up _____

Drilling and Remarks:

Surface
~~Service~~ Hole

RECORD

Cased _____ in., _____ ft.

Sand _____

Gas _____

Oil _____

Total Depth _____

PRODUCTION

1st 24 hrs. Nat. _____

1st 24 hrs. after shot _____

Gas _____ Cu. Ft.

Dry Hole _____

Abandoned _____

Date

AUG 16 1944 19

S. J. LEWIS Scout

