


Section 34 Township 16 Range 10-W

Well No. #1 Pistoria Phillips

Company Branine & Goering

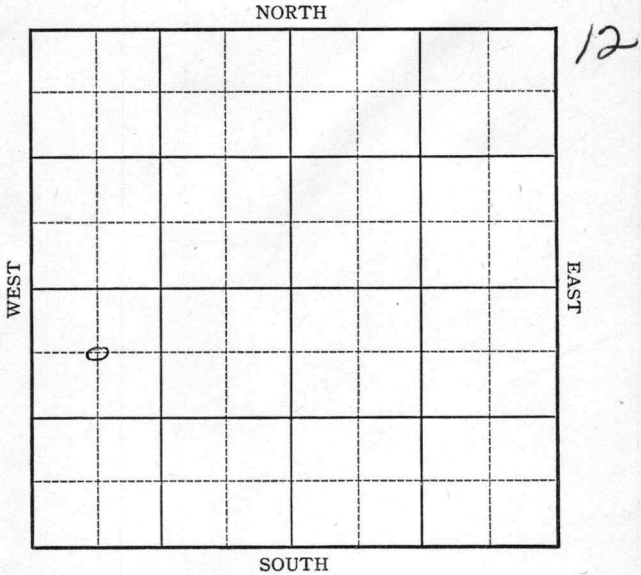

Sec. 34 Twp. 16 R. 10-W

Well No. #1 ~~Pistoria~~ Phillips Farm

Branine & Goering Company


Wildcat

660 Ft. from N. Line

         Ft. from S. Line

         Ft. from E. Line

660 Ft. from W. Line

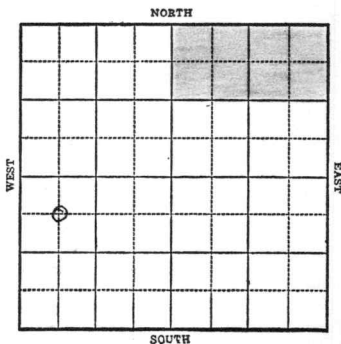

1943

**R E P O R T**

4/7	Derrick
4/14	"
4/21	"
4/28	"
5/5	"
5/12	"
5/19	"
5/26	"
6/2	"
6/9	8" @ 360' Drlg. 2345'
6/16	Lans 2948 Arb. 3250-53 T.D. 5" @ 3251' RUST
6/23	T.D. 3269' 1200' oil SD for tanks.
6/30	" "
7/7	" "
7/14	" "
7/21	" "
7/28	" "
8/4	Arb. 3250 5" @ 3251' T.D. 3269' Gravity 42.6

**COMPLETED**

Ellsworth

KANSAS

Map No. 55 Sec. 34 Twp. 16 R. 10W

Well No. 1 Pistoria

Branine & Goering Company

FIRST REPORT Contractor

C NW SW

SECTION PLAT

660 Ft. from N. Line

\_\_\_\_\_ Ft. from S. Line

\_\_\_\_\_ Ft. from E. Line

660 Ft. from W. Line

0			

WILDCAT

Location \_\_\_\_\_

Rig up \_\_\_\_\_

Drilling and Remarks:

Derrick

RECORD

Cased \_\_\_\_\_ in., \_\_\_\_\_ ft.

Sand \_\_\_\_\_

Gas \_\_\_\_\_

Oil \_\_\_\_\_

Total Depth \_\_\_\_\_

PRODUCTION

1st 24 hrs. Nat. \_\_\_\_\_

1st 24 hrs. after shot \_\_\_\_\_

Gas \_\_\_\_\_ Cu. Ft.

Dry Hole \_\_\_\_\_

Abandoned \_\_\_\_\_

Date

APR 7 1943 19

S. J. LEWIS Scout

Ellsworth

KANSAS

Map No. 33 Sec. 34 Twp. 16 R. 10W

Well No. 1 Phillips

Branine & Goering Company

COLLECTION Contractor

C NW SW

SECTION PLAT

660 Ft. from N. Line

\_\_\_\_\_ Ft. from S. Line

\_\_\_\_\_ Ft. from E. Line

660 Ft. from W. Line

o			

WILDCAT

Location \_\_\_\_\_

Rig up \_\_\_\_\_

Drilling and Remarks:

Reported as

#1 Pistoria

RECORD

Cased \_\_\_\_\_ in., \_\_\_\_\_ ft.

Sand \_\_\_\_\_

Gas \_\_\_\_\_

Oil \_\_\_\_\_

Total Depth \_\_\_\_\_

PRODUCTION

1st 24 hrs. Nat. \_\_\_\_\_

1st 24 hrs. after shot \_\_\_\_\_

Gas \_\_\_\_\_ Cu. Ft.

Dry Hole \_\_\_\_\_

Abandoned \_\_\_\_\_

Date

APR 14 1943 19

S. J. LEWIS Scout

Ellsworth

KANSAS

Map No. 55 Sec. 34 Twp. 16 R. 10W

Well No. 1 Phillips

Branine & Goering Company

COMPLETED Contractor

C NW SW

660 Ft. from N. Line

\_\_\_\_\_ Ft. from S. Line

\_\_\_\_\_ Ft. from E. Line

660 Ft. from W. Line

SECTION PLAT


STOLTENBERG POOL

Location \_\_\_\_\_

Rig up \_\_\_\_\_

Drilling and Remarks:

*Cor 83250*

*5" C 3251*

*Pump 56 P.D.*

*42 1/2 Gr*

RECORD

Cased \_\_\_\_\_ in., \_\_\_\_\_ ft.

Sand \_\_\_\_\_

Gas \_\_\_\_\_

Oil \_\_\_\_\_

Total Depth 3268

PRODUCTION

1st 24 hrs. Nat. \_\_\_\_\_

1st 24 hrs. after shot \_\_\_\_\_

Gas \_\_\_\_\_ Cu. Ft.

Dry Hole \_\_\_\_\_

Abandoned \_\_\_\_\_

Date

AUG 4 1943 19

S. J. LEWIS Scout