



Sec. 19 Twp. 25 R. 5E ✓

Well No. 45 Hazlett Farm

Skelly Company

Butler County


NORTH

           Ft. from N. Line

990 Ft. from S. Line

990 Ft. from E. Line

           Ft. from W. Line

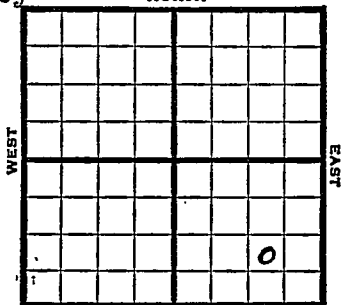

NW SE SE

Elev 1388'

SOUTH

1947 **REPORT**

3/26

50'

4/2

10" @ 150  
Drlg. 2330'

4/9

Viola 2474'  
7" @ 2473'  
TD 2476'  
Shot 215 oil & 38 w/ in 19 hrs.

4/16

Viola 2474  
7" @ 2473  
Pump 124 oil & 10W Pot  
Grav. 38  
TD 2476'

**COMPLETED**

Map No. 114 Sec. 19 Twp. 25 R. 5E

Well No. 45 Hazlett

Skelly Company

**FIRST REPORT**

Contractor

NW SE SE

\_\_\_\_\_ Ft. from N. Line

990 Ft. from S. Line

990 Ft. from E. Line

\_\_\_\_\_ Ft. from W. Line

**SECTION PLAT**

			o

Butler County

Location \_\_\_\_\_

Rig up \_\_\_\_\_

Drilling and Remarks:

50'

**RECORD**

Cased \_\_\_\_\_ in., \_\_\_\_\_ ft.

Sand \_\_\_\_\_

Gas \_\_\_\_\_

Oil \_\_\_\_\_

Total Depth \_\_\_\_\_

**PRODUCTION**

1st 24 hrs. Nat. \_\_\_\_\_

1st 24 hrs. after shot \_\_\_\_\_

Gas \_\_\_\_\_ Cu. Ft.

Dry Hole \_\_\_\_\_

Abandoned \_\_\_\_\_

Date

MAR 26 1947 19

S. J. LEWIS Scout

