


Section 32 Township 32 Range 7 EWell No. # 1 RadcliffCompany Carter Oil

NORTH

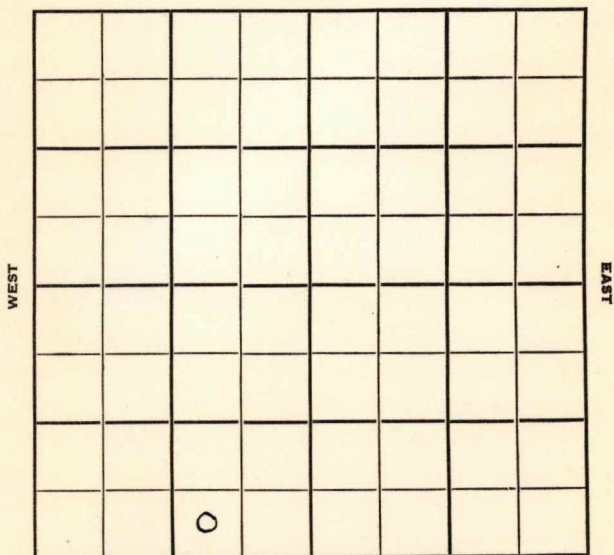

SOUTH

Cowley

KANSAS

Sec. 32 Twp. 32 R. 7E

Well No. #1 Radcliff Farm

Carter Oil Company

Contractor

Wildcat


Ft. from N. Line

330' Ft. from S. Line

990' Ft. from E. Line

Ft. from W. Line

SW SE SW

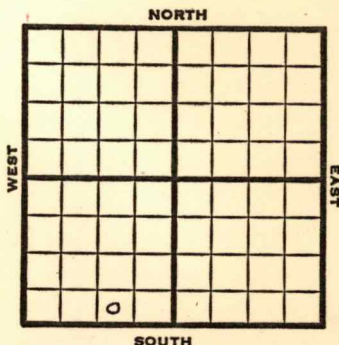

1951

Elev. 1205' REPORT

4/18 Location

5/9 Spud 4-18-51
D&A TD 2851
8" @ 116

Howard 690' Top 858'
Heeb. 1250 Tor. 1310'
Lans. 1544' Stal 1592
2nd Lans. 1759 Layton 1943
Sand 1958 KC 2161
BKC 2316 Oswego 2380-2534
Burgess 2776' Miss ch 2787
Miss lime 2804 TD 2851'
D&A

ABANDONED

Operator Carter Oil

Well No. 1 Farm Radcliff

[illegible]

FIRST REPORT

330 Ft. From S Line SW

990 Ft. From E Line Quarter

1st. Report APR 18 1951

Completion

Remarks Seismograph

Spudding Date _____

Drig. Data Wildcat

Location

J. E. TYRA

County Cowley State KansasSec. 32 (Blk. Twp.) 32 (Sur. Rge.) 7E Map No.Operator Carter OilWell No. 1 Farm RadcliffElev. 1205 Location SW SE SW330 Ft. From S Line SW990 Ft. From E Line Quarter

1st. Report

Completion MAY 9 1951Remarks WildcatSpudding Date 4-18-51Drilg. Data D & A TD 28518" @ 116 Howard 690 Top. 858Heeb. 1250 Tor. 1310 Lans. 1544Stal. 1592 2nd Lans. 1759 Layton 1943Sand 1958 KC 2161 B KC 2316Oswego 2380-2534 Burgess 2776Miss. ch. 2787 Miss. lime 2804 TD 2851D & A

J. E. TYRA