

KANSAS

FORM 51 5M 1-42 PETROL

Butler

Section 19 Township 25 Range 5-E

Well No. #24 Pirtle

Company Cities Service

NORTH

							0

SOUTH

WEST


EAST

KANSAS

Butler

Sec. 19 Twp. 25 R. 5-EWell No. #24 Pirtle FarmCities Service Oil Company330 Ft. from N. Line Ft. from S. Line330~~990~~ Ft. from E. Line Ft. from W. Line

Miscellaneous

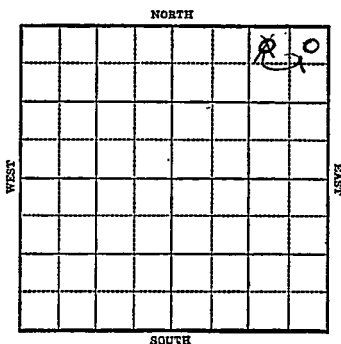

1943

Elev. 1382 R E P O R T

7/28

Location

8/4

10" @ 97'
Drlg. 936'

8/11

Lans 1789
Chat 2489
T.D. 2493
7" @ 2489'
Rust

8/18

"

8/25

T.D. 2596'

9/1

T.D. 2598-270 qts 2563-98 C.O.

9/8

Swab 35 oil in 8 hrs.

9/15

" " " " "

9/22

" " " " "

9/29

" " " " "

10/6

" " " " "

10/13

" " " " "

10/20

" " " " "

10/27

" " " " "

11/3

" " " " "

OVER

1943

11/10

Chat 2489

7" @ 2489

T.D. 2598'

270 qts 2563-98

Pump 60 Pot.

Gravity 36.3

COMPLETED

Map No. 14 Sec. 19 Twp. 25 R. 5E

Well No. 24 Pirtle

Cities Service Oil Company

FIRST REPORT

Contractor

NW NE NE

SECTION PLAT

330 Ft. from N. Line

 Ft. from S. Line

990 Ft. from E. Line

 Ft. from W. Line

			0

MISCELLANEOUS

Location XXX

Rig up

Drilling and Remarks:

RECORD

Cased in., ft.

Sand

Gas

Oil

Total Depth

PRODUCTION

1st 24 hrs. Nat.

1st 24 hrs. after shot

Gas Cu. Ft.

Dry Hole

Abandoned

Date

JUL 28 1943 19

S. J. LEWIS Scout

KANSAS

Butler

Map No. 14 Sec. 19 Twp. 25 R. 5EWell No. 24 Pirtle

Cities Service Company

CORRECTION Contractor

NE/C

SECTION PLAT

			o

330 Ft. from N. Line Ft. from S. Line330 Ft. from E. Line Ft. from W. Line

MISCELLANEOUS

Location Rig up

Drilling and Remarks:

Reported

NW NE NE

RECORD

Cased in., ft.Sand Gas Oil Total Depth

PRODUCTION

1st 24 hrs. Nat. 1st 24 hrs. after shot Gas Cu. Ft. Dry Hole Abandoned

Date

AUG 4 1943 19S. J. LEWIS Scout

KANSAS

Map No. 14 Sec. 19 Twp. 25 R. 5EWell No. 24 Pirtle

Cities Service Oil Company

COMPLETED

Contractor

NE/C

SECTION PLAT

330 Ft. from N. Line Ft. from S. Line330 Ft. from E. Line Ft. from W. Line

			6

Miscellaneous

Location Rig up

Drilling and Remarks:

*Chay 2489**7" @ 2489**2709 to 2563-98**Prod 60 Pz**863 Gr*

RECORD

Cased in., ft.Sand Gas Oil Total Depth 2489

PRODUCTION

1st 24 hrs. Nat. 1st 24 hrs. after shot Gas Cu. Ft.Dry Hole Abandoned

Date

NOV 10 1943 19 S. J. LEWIS Scout