

Butler

Map No. _____ Sec. 19 Twp. 25 R. 5 E

Well No. 2 - Pirtle _____ Farm


Swartz et al _____ Company

_____ Ft. from N. Line

600 Ft. from S. Line

_____ Ft. from E. Line

1000 Ft. from W. Line

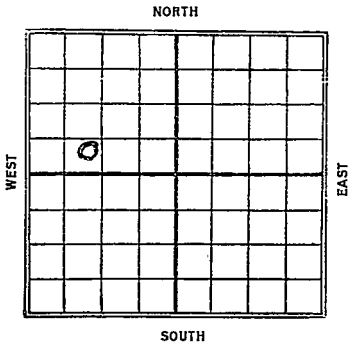

1927

Date	REPORT
------	--------

6/29	Sand 731-740' T.D. 740 20/15 bbls
------	--------------------------------------

Butter £

14 KANSAS

Map No. _____ Sec. *19* Twp. *25* R. *5*

Well No. *2* *Pulte*

Swartz et al

Company

Contractor

FIRST REPORTS

SECTION PLAT

COMPLETED

_____ Ft. from N. Line

600 Ft. from S. Line

_____ Ft. from E. Line

1000 Ft. from W. Line

o			

Location _____

Rig up _____

Drilling and Remarks:

20/15 Pkls.

RECORD

Cased _____ in., _____ ft.

Sand *731-740*

Gas _____

Oil _____

Total Depth *740*

PRODUCTION

1st 24 hrs. Nat. _____

1st 24 hrs. after shot _____

Gas _____ Cu. Ft.

Dry Hole _____

Abandoned _____

Date

June 29 1927

CHAS. L. SHERWOOD

Scout