



Map No. *Kansas* Sec. *19* Twp. *25* R. *5*


Well No. *11- Pirtle* Farm  
*Empire* Company

\_\_\_\_\_ Ft. from N. Line

*792* Ft. from S. Line

*792* Ft. from E. Line

\_\_\_\_\_ Ft. from W. Line

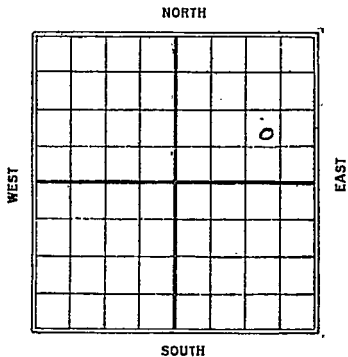

*1926.*

Date

REPORT

*4/21 Location*

*4/30* \_\_\_\_\_

*5/8 D.L. 400'*

*5/19 J.D. 760' D. + A.*

*Butler*

*K14* Map No. **KANSAS** Sec. *19* Twp. *25* R. *5*

Well No. *11 Hintle*

*Empire Oil & Gas Co.* Company

Contractor

**FIRST REPORTS**

**SECTION PLAT**

\_\_\_\_\_ Ft. from N. Line

*792* Ft. from S. Line

*792* Ft. from E. Line

\_\_\_\_\_ Ft. from W. Line

			9

Location

Rig up \_\_\_\_\_

Drilling and Remarks:

**RECORD**

Cased \_\_\_\_\_ in., \_\_\_\_\_ ft.

Sand \_\_\_\_\_

Gas \_\_\_\_\_

Oil \_\_\_\_\_

Total Depth \_\_\_\_\_

**PRODUCTION**

1st 24 hrs. Nat. \_\_\_\_\_

1st 24 hrs. after shot: \_\_\_\_\_

Gas \_\_\_\_\_ Cu. Ft.

Dry Hole \_\_\_\_\_

Abandoned \_\_\_\_\_

Date

APR 21 1926

**CHAS. L. SHERWOOD**

192

Scout

Button

K14 KANSAS  
 Map No. \_\_\_\_\_ Sec. 19 Twp. 25 R. 5

Well No. 11  
 Comp No. 420 3 Co  
 \_\_\_\_\_ Company

\_\_\_\_\_ Contractor

**COMPLETED**

**SECTION PLAT**

\_\_\_\_\_ Ft. from N. Line

792 Ft. from S. Line

792 Ft. from E. Line

\_\_\_\_\_ Ft. from W. Line

			o

**ABANDONED**

Location \_\_\_\_\_

Rig up \_\_\_\_\_

Drilling and Remarks:

DOG  
 760'

**RECORD**

Cased \_\_\_\_\_ in., \_\_\_\_\_ ft.

Sand \_\_\_\_\_

Gas \_\_\_\_\_

Oil \_\_\_\_\_

Total Depth 760

**PRODUCTION**

1st 24 hrs. Nat. \_\_\_\_\_

1st 24 hrs. after shot. \_\_\_\_\_

Gas \_\_\_\_\_ Cu. Ft.

Dry Hole

Abandoned

Date

MAY 12 1926

CHAS. L. SHERWOOD

192 Scout