


DX 78-1 Cowley

**KANSAS**

Section 33 Township 32S Range 7E

Well No. #2 Graham

Company Lester Cox (Springfield, Mo.)

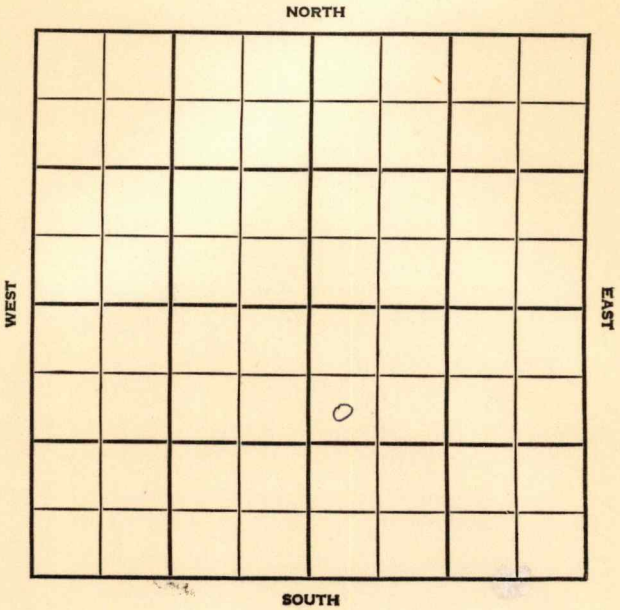

Cowley


SEC. 33	TWP. 32S	R. 7E
------------	-------------	----------

WELL NO. #2 Graham FARM

COMPANY Lester Cox (Springfield, Mo.)

CONTRACTOR Curt Brown  
Countryman

\_\_\_\_\_ FT. FROM N. LINE  
 \_\_\_\_\_ FT. FROM S. LINE  
 \_\_\_\_\_ FT. FROM E. LINE  
 \_\_\_\_\_ FT. FROM W. LINE

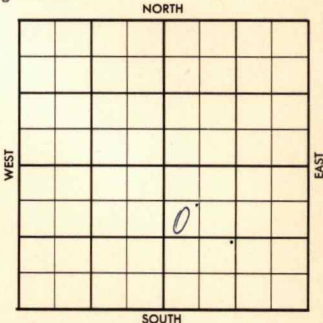

SW NW SE (TWIN)

1956	ELEVATION	REPORT
------	-----------	--------

8-1 Comm. 7-29-56  
 10" @ 100 w/80  
 Drlg. 473

**COMPLETED**

County Cowley Elev. 1268  
 Sec. 33 Twp. 32S Rge. 7E  
 Company Lester Cox (Springfield, Mo.)  
 Farm Name Graham No. 2

TOPS	DEPTH	LOG	DATUM	Loc. in Sec.
Anb.				SW NW SE
Tr.	<u>Lay</u>	<u>1985-2001</u>		<u>Arnie</u>
Dg.				
BL.				
L.				
K.C.				Geol. L. Arnold (Tulsa)
B.K.C.				Contr.
Ce.				Curt Brown
C.				
M.				Pool
M.				Countryman
K.				
Mz.				
Mo.				
V.				
S.				
S.				
A.				
R.				
Pe.				
G.				
T.D.	<u>2030</u>			COMPLETE
				SEP 2 '56

Date Comm. 7-29-56  
 10" 100 w/80; D 473 AUG 8 '56 5 1/2 @ 2030

AUG 15 '56  
 SEP 12 '56  
 AUG 22 '56  
 AUG 29 '56  
 SEP 5 '56

60/2005-09 @ 1/2 B0  
ph + Tr w/ 3 hrs frac est  
P. 25 Bopd + 6 BWpd.

County Cowley Elev. \_\_\_\_\_  
 Sec. 33 Twp. 32S Rgs. 7E  
 Company Lester Cox (Springfield, Mo.)  
 FarmName Graham No. 2

TOPS	DEPTH	LOG	DATUM
Anh.			
TP.			
H.			
Tr.			
Dg.			
Bl.			
L.			
K.C.			
B.K.C.			
Ce.			
C.			
M.			
M.			
K.			
Mz.			
Me.			
V.			
S.			
S.			
A.			
R.			
PE.			
G.			
T.D.			

Loc. in Sec. \_\_\_\_\_  
SW NW SE  
twin  
 Geol. L. Arnold  
(Tulsa)  
 Contr. \_\_\_\_\_  
Curt Brown  
 Pool \_\_\_\_\_  
Countryman



Date Comm. 7-29-56 AUG 1 1956  
10" 100 w/80; D 473

AUG 5 1956  
 R.G.

*35*

Co.  
 Lse.  
 No.  
 Sec.  
 T.  
 R.