


DX 78-1 Cowley

KANSAS

Section 33 Township 32S Range 7E

Well No. #4 Redcliff

Company Lester Cox

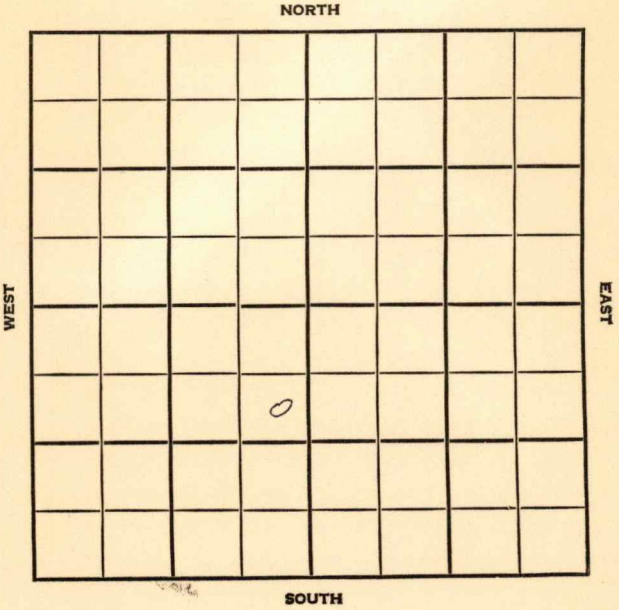

SEC. 33

TWP. 33

R. 7E


WELL NO. #4 Redcliff FARM

COMPANY Lester Cox

CONTRACTOR Curt Brown

Countryman

_____ FT. FROM N. LINE
_____ FT. FROM S. LINE
_____ FT. FROM E. LINE
_____ FT. FROM W. LINE

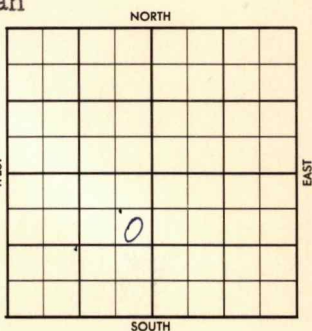

SE NE SW

1956 ELEVATION 1251' REPORT

8-1 Comm. 7-17-56
 8" @ 120 w/60
 RTD 2760
 5" @ 2037 w/100
 Ran Log
 CO 2037
 Perf 124/1954-57;
 Test 1/2 boph, no wtr.;
 frac; testing;
 Lay. 1937'; M. 2660';

8-22 Rec. load
 P/ 100 BO / 10 BWPD;
 P/ 25 BO / 5 BWPD.
 TD 2760'

COMPLETED

County Cowley Elev. _____
 Sec. 33 Twp. 32S Rge. 7E
 Company Lester Cox
 Farm Name Redcliff No. 4

TOPS	DEPTH	LOG	DATUM	Loc. in Sec.
Anh.				SE NE SW
Tr.				
H.				
Da.				
BT. <u>Lay.</u>	<u>1937</u>			
L.				Geol. <u>E.L. Arnold</u>
K.C.				Contr. <u>Curt Brown</u>
B.K.C.				Pool
Ce.				<u>Countryman</u>
C.	<u>2660</u>			
M.				
M.				
K.				
Mz.				
Ma.				
V.				
S.				
S.				
A.				
R.				
PE.				
G.				
TD.				

FIRST REPORT

Date Comm. 7-17-56 AUG 1 1956

8" 120 w/60; RTD 2760; 5" 2037 w/100;
 ran log; CO 2037; perf 124/1954-57;
 test 1/2 boph no wtr.; frac; testing

AUG 1 1956

R.G.

Handwritten signature

Co.
Lse.
No.
Sec.
T.
R.

Co.

County Cowley Elev. 1257
 Sec. 33 Twp. 32S Rge. 7E
 Company Lester Cox
 Farm Name Redcliff No. 4

	TOPS	DEPTH	LOG	DATUM
Anh.				
Tp.				
H.				
Tr.				
Dg.				
BT	<u>Lily</u>	<u>1937</u>		
L.				
K.C.				
B.K.C.				
Ce.				
C.				
M.		<u>2660</u>		
M.				
K.				
Mz.				
Me.				
V.				
S.				
S.				
A.				
R.				
PE.				
G.				
TD.		<u>2760</u>		

Loc. in Sec. SE NE SW
1100 NL
2012L
 Geol. W.L. Arnold

Contr. Curt Brown
 Pool
 Countryman



AUG 22 1956

Date Comm. 7-17-56
8" 120 w/60; RTD 2760; 5" 2037 w/100;
ran log; CO 2037; perf 124/1954-57;
test 1/2 boph no wtr.; frac; testing
 AUG 8 '56 Rec Ld POP. AUG 15 '56
P 100 B0 + 10 BWpd AUG 22 '56
P. 25 B0 + 5 BWpd.

Loc.

No.

Sec.

T.

R.