


Form 51-5M-4-21-21425
KANSAS
Map No. _____ Sec. 33 Twp. 52 R. 7

Map No. _____ Sec. _____ Twp. _____ R. _____

Well No. 2 - Reynolds Farm
Blue Stem Oil Company

Company

NORTH

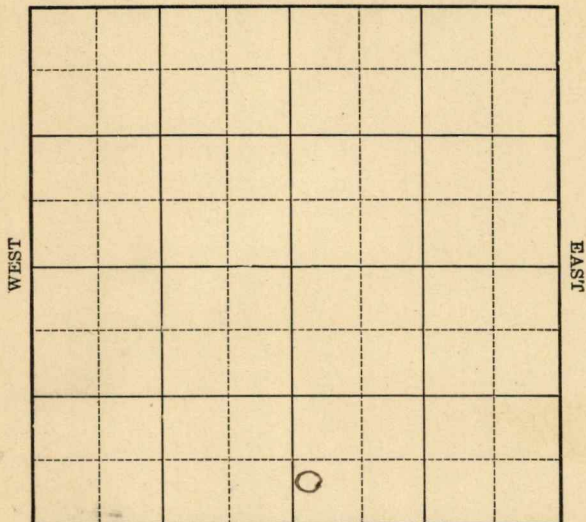

SOUTH

Location

Drilling Remarks

Rig Up_____

Drilling Remarks

RECORD

Cased _____ in. _____ ft.

Sand

Gas

Oil

Total Depth

PRODUCTION

1st 24 hrs. Nat. -----

1st 24 hrs. after shot_____

Gas _____ cu. ft.

Dry Hole_____

Abandoned

Map No. K Sec. 33 Twp. 32 R. 7Well No. 2 - Reynolds FarmBlue Stem oil Company

NORTH

_____ Ft. from N. Line

400 Ft. from S. Line

_____ Ft. from E. Line

200 Ft. from W. Line

WEST

EAST

SOUTH

1927

Date

REPORT

10/6 Drilg 450'
10/12 " 950
10/19 1007-1018-T.D. 1018
5 # Helium gas

Cowley
3 **KANSAS** *33* *32* *7*
 Map No. _____ Sec. _____ Twp. _____ R. _____
2 Reynolds
 Well No. _____
Blue Stem Oil Co Company _____

Contractor _____

COMPLETED**SECTION PLAT**

_____ Ft. from N. Line

400 _____ Ft. from S. Line

_____ Ft. from E. Line

200 _____ Ft. from W. Line

Location _____

Rig up _____

Drilling and Remarks:

*Helium Gas.***RECORD**

Cased _____ in., _____ ft.

Sand *1007-1018*

Gas _____

Oil _____

Total Depth *1018***PRODUCTION**

1st 24 hrs. Nat. _____

1st 24 hrs. after shot _____

Gas *5 1/4* _____ Cu. Ft.

Dry Hole _____

Abandoned _____

Date

OCT 19 1927**CHAS. L. SHERWOOD**

192

Scout

3 **KANSAS** 33 32
 Map No. _____ Sec. _____ Twp. _____ R. _____
 Well No. 2 Reynolds
 Blue Stem Oil Co Company

Contractor _____

FIRST REPORTS**SECTION PLAT**

		0	

_____ Ft. from N. Line

400 _____ Ft. from S. Line

_____ Ft. from E. Line

200 _____ Ft. from W. Line

for 500

Location _____

Rig up _____

Drilling and Remarks:

dy 450

RECORD

Cased _____ in., _____ ft.

Sand _____

Gas _____

Oil _____

Total Depth _____

PRODUCTION

1st 24 hrs. Nat. _____

1st 24 hrs. after shot _____

Gas _____ Cu. Ft.

Dry Hole _____

Abandoned _____

Date

OCT 6 - 1927

192

CHAS. L. SHERWOOD

Scout