


Section 33 Township 32 Range 7E

Well No. #1 Graham

Company Berry & Fick

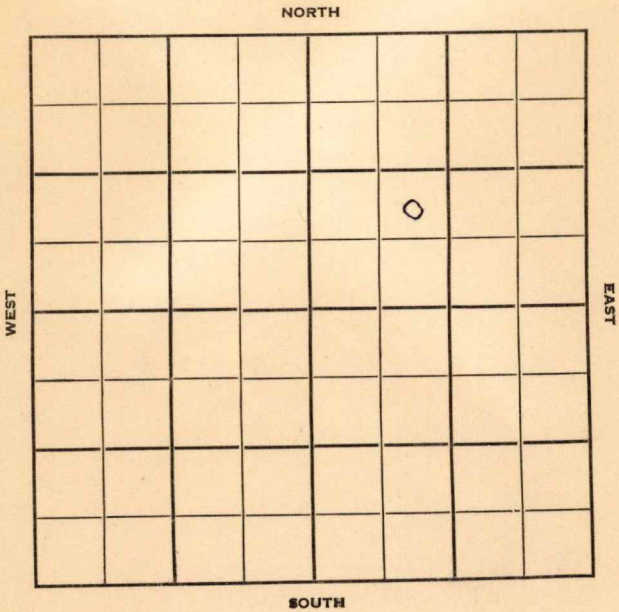

Sec. 33 Twp. 32 R. 7 E

Well No. # 1 Graham Farm

Berry & Fick Company

H. E. Brandenburg Contractor


..... Ft. from N. Line

990 Ft. from S. Line

..... Ft. from E. Line

990 Ft. from W. Line

NE SW NE

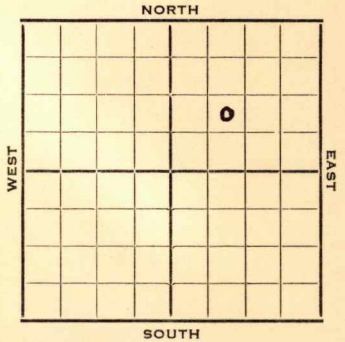

1952 **Elev. 1311'** REPORT

4/16 Spud 3-31-52
12" @ 405'
10" @ 750'
Drlg. 802'

6/25 Spud 3-31-52
D&A TD 2025
12" @ 405 10" @ 750 8" @ 1015
6" @ 1320 TD 2025
D&A

ABANDONED

