

Map No. KANSAS Sec. 22 Twp. 22 R. 1

Well No. 15 Maple Farm

Company

WEST

EAST

SOUTH

Location _____
 Drilling Remarks _____

Rig Up _____
Drilling Remarks

RECORD

Cased _____ in. _____ ft.

Sand_____

Gas _____

Oil_____

Total Depth-----

PRODUCTION

1st 24 hrs. Nat.-----

1st 24 hrs. after shot_____

Gas_____cu. ft._____

Dry Hole-----

Abandoned_____

Map No. **KANSAS** Sec. 33 Twp. 32 R. 7E
Well No. 1-Marbur Farm
Superior et al Company


_____ Ft. from N. Line

330 Ft. from S. Line

_____ Ft. from E. Line

330 Ft. from W. Line

1931

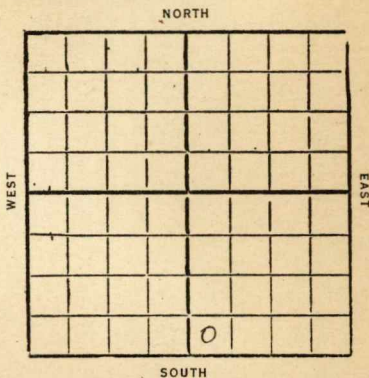

Date

REPORT

2/11	Ry
2/18	
2/25	
3/4	
3/11	Spud 200'
3/18	Drilg 840'
3/25	" 1250'
4/11	10"-1050
	drilg 1485
4/8	SID 1503 for 6"
4/15	
4/22	Fsg 2020'
4/29	6"-2273
5/6	SID 2273'
5/13	SID 2800'
5/20	
5/27	
5/31	T.D. 2799 (corrected)
	Dry & Abandon

KANSAS

Cowley

33

Twp. 32

R. 7

E

Map No. _____ Sec. _____ Twp. _____ R. _____

Well No. 3 1 Marker _____

Supper et al _____ Company

_____ Contractor

COMPLETED**SECTION PLAT**

_____ Ft. from N. Line

330 _____ Ft. from S. Line

_____ Ft. from E. Line

330 _____ Ft. from W. Line

ABANDONED

Location _____

Rig up _____

Drilling and Remarks: _____

RECORD

Cased _____ in., _____ ft.

Sand _____

Gas _____

Oil _____

Total Depth 2799 _____

PRODUCTION

1st 24 hrs. Nat. _____

1st 24 hrs. after shot _____

Gas _____ Cu. Ft.

Dry Hole ☒ _____Abandoned ☒ _____

Date

JUN 3

1931

CHAS. L. SHERWOOD

192

Scout

Map No. **KANSAS** Sec. 33 Twp. 22 R. 7E

Well No. 1 Marker

Supper & Co Company

Contractor

SECTION PLAT

Ft. from N. Line

330 Ft. from S. Line

Ft. from E. Line

330 Ft. from W. Line

FIRST REPORTS

Location

Rig up

Drilling and Remarks:

Rig

RECORD

Cased in., ft.

Sand

Gas

Oil

Total Depth

PRODUCTION

1st 24 hrs. Nat.

1st 24 hrs. after shot

Gas Cu. Ft.

Dry Hole

Abandoned

Date

FEB 1 1 1931 192 S. J. LEWIS Scout