


Section 33 Township 32 Range 7 E

Well No. # 1 Parsons

Company Gross Drig.

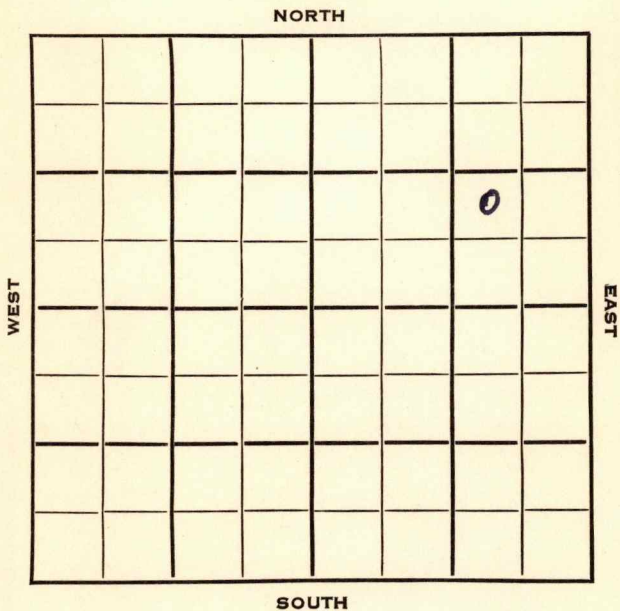

Sec. 33 Twp. 32 R. 7E

Well No. #1 Parson Farm

Gross Drlg. _____ Company

Gross Drlg. _____ Contractor
Countryman Pool


_____ Ft. from N. Line

990 Ft. from S. Line

990 Ft. from E. Line

_____ Ft. from W. Line

NW SE NE

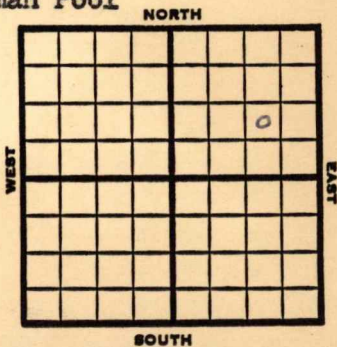

1953 **Elev. 1306'** REPORT

8/26 Spud 8-21-53
 8" @ 64'
 Drlg.

10/14 Spud 8-21-53
 D & A
 TD 2045'
 8" @ 64'
Layton 2022'
 TD 2045'
 5" @ 2025'
 CO to 2043 SP 2038 S/ 30 bwph
 PB 2027
 CO to 2038
 20 gwph wtr.
 D & A

ABANDONED

County Cowley State Kansas

Sec. 33 (Blk. 32) (Twp. 7E) (Sur. Rge.) 7E Map No.

Operator Gross Drlg.

Well No. 1 Farm Parson

Elev. 1306 Location NW SE NE

990 Ft. From S Line NE

990 Ft. From E Line Quarter

1st. Report

Completion OCT 14 1953

Remarks Countryman Pool

Gross Drlg. - Contr.

Spudding Date 8-21-53

ABANDONED

Drlg. Data D & A TD 2045

8" @ 64 Layton 2022 TD 2045 5" @ 2025

CO to 2043 SP 2038 S/ 30 bwph PB 2027

CO to 2038 20 gwph wtr.

D & A

