


Section 33 Township 32 Range 7E

Well No. 2 #1 Parsons

Company Gross Drlg.

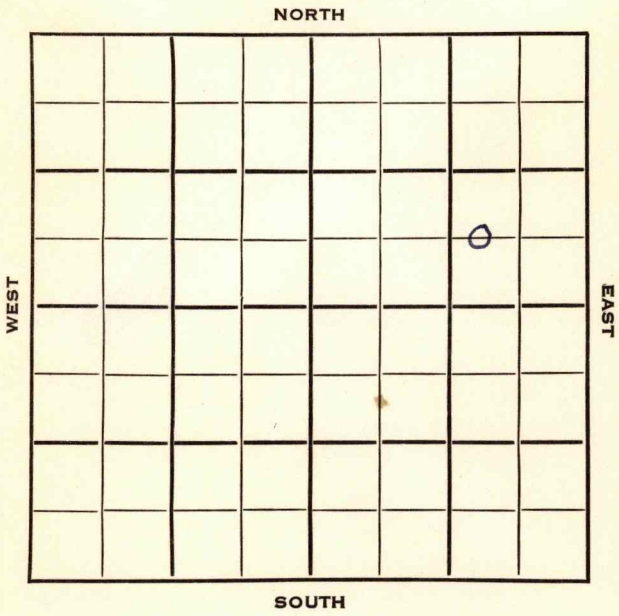

Cowley


KANSAS

SEC.	TWP.	R.
33	32	7E

WELL NO. _____
 2 Parsons FARM
 COMPANY

CONTRACTOR
 Gross Drlg.
 Gross Drlg.

_____ Ft. from N. Line
 590 _____ Ft. from S. Line
 990 _____ Ft. from E. Line
 _____ Ft. from W. Line

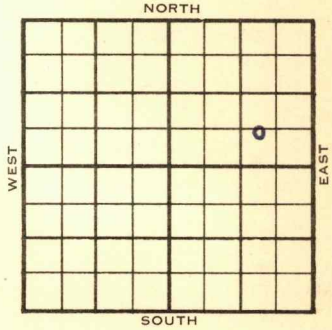

C W L S E N E

1953	ELEVATION 1293'	REPORT
------	--------------------	--------

9/23 Spud 9-21-53
 Drlg. 300'

10/14 Spud 9-21-53
 Layton 2009'
 TD 2037'
 HFW
 D & A

ABANDONED

