


Map No. 15 Sec. 33 Twp. 32 R. 7E
Well No. 1- Radcliff Farm
White Eagle O. & R. Company
T.B. Slick et al
NORTH

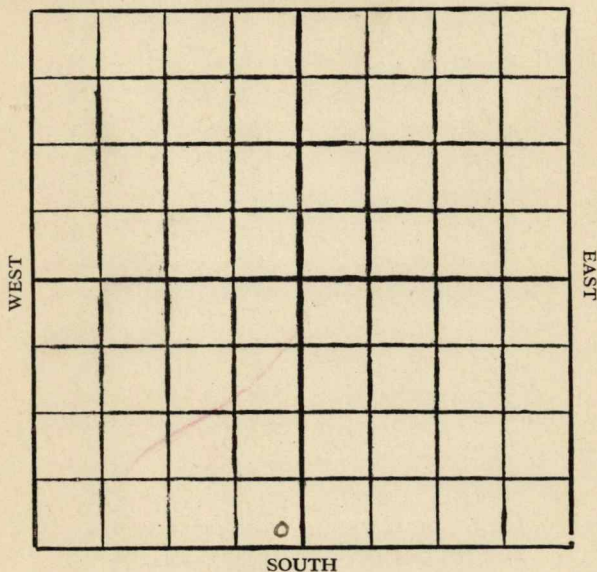

Location _____

Drilling Remarks

Rig Up.....

Drilling Remarks

RECORD

Cased.....in.ft.

Sand

Gas

Oil -----

Total Depth.....

PRODUCTION

1st 24 hrs. Nat.

1st 24 hrs. after shot.....

Gas..... cu. ft.

Dry Hole

Abandoned -----


cowley

Map No. 15 Sec. 33 Twp. 32 R. 7EWell No. 1- Radcliff Farm~~White Eagle Oil & R.~~ CompanyT. B. Slick et al NORTH

Ft. from N. Line

250 Ft. from S. Line250 Ft. from E. Line

Ft. from W. Line

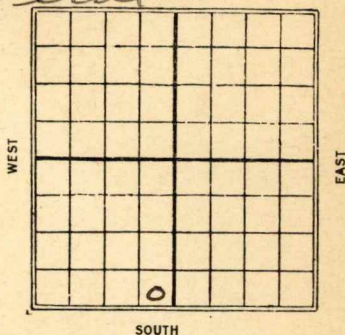

1927

Date

REPORT

1/6 Location

1/13

1/19

1/26

2/3

2/10

4/17

2/24

3/2

3/9

3/16

3/24

4/6 Rig up

4/13 Rigging up

4/20

4/27 Dry 200

5/5 " 835

5/12 " 1025

5/18 " 1450

5/25 5 MG gas 1023-37-U.R. 10"-1485

6/1

6/7 Top Run Sand 1925 Dry

6/16 T.D. 1958'-P.R. to 1956

40/50 bbls oil
10 " water
3.5 gravity

Cowley
 3 KANSAS 33 32 7
 Map No. Sec. Twp. R.
 Well No. 1 Cas Cliffs
 T. B. Shicks et al Company

Contractor

CORRECTION

SECTION PLAT

Ft. from N. Line

250

Ft. from S. Line

250

Ft. from E. Line

Ft. from W. Line

	0		

Location

Rig up ✓

Drilling and Remarks:

by Ownership
 to chover

RECORD

Cased _____ in., _____ ft.

Sand _____

Gas _____

Oil _____

Total Depth _____

PRODUCTION

1st 24 hrs. Nat. _____

1st 24 hrs. after shot _____

Gas _____ Cu. Ft.

Dry Hole _____

Abandoned _____

Date

APR

6 1927

CHAS. L. SHERWOOD

192

Scout

Cowley
3 **KANSAS** Sec. *33* Twp. *32* R. *7*^E
Well No. *1* *Badcliff*
White Eagle Oil Company
Contractor

FIRST REPORTS

-----Ft. from N. Line
250
-----Ft. from S. Line
250
-----Ft. from E. Line
-----Ft. from W. Line

SECTION PLAT

Location ☒ -----
Rig up -----
Drilling and Remarks:

RECORD

Cased ----- in., ----- ft.
Sand -----
Gas -----
Oil -----
Total Depth -----

PRODUCTION

1st 24 hrs. Nat. -----
1st 24 hrs. after shot -----
Gas ----- Cu. Ft.
Dry Hole -----
Abandoned -----

Date
JAN 6 1927

CHAS. L. SHERWOOD

-----192----- Scout

Cowley
 3 KANSAS 33 32 7
 Map No. Sec. Twp. R.
 Well No. 1 Badcliff
 T. B. Slick et al Company

Contractor

COMPLETED

SECTION PLAT

Ft. from N. Line

250 Ft. from S. Line

250 Ft. from E. Line

Ft. from W. Line

Location Peru

Rig up

Drilling and Remarks:

PB to 1956'

40y 50 BB oil
10 " water

35 Gravity.

RECORD

Cased in., ft.

Sand 1922-1958

Gas

Oil

Total Depth 1958

PRODUCTION

1st 24 hrs. Nat.

1st 24 hrs. after shot

Gas Cu. Ft.

Dry Hole

Abandoned

Date

JUN 16 1927

CHAS. L. SHERWOOD

192

Scout