

Sec. 1 Twp. 32 Range 8E <sup>Chautauqua</sup>


# 1 Wusterfield  
Kansas Geological Society

Syndicate O & G  
Skelly Scout Tickets

Map No. **KANSAS** Sec. 1 Twp. 32 R. 8<sup>E</sup>

Well No. 1 - Westfield Farm  
Syndicate Oil Company

990 Ft. from N. Line  
\_\_\_\_ Ft. from S. Line  
\_\_\_\_ Ft. from E. Line  
330 Ft. from W. Line

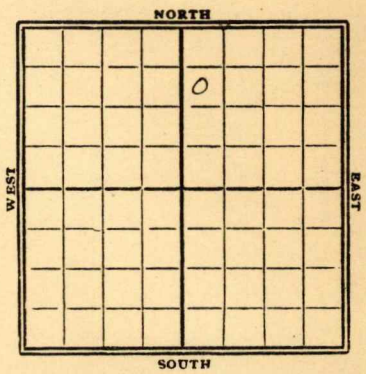

1929

Date	REPORT
3/20	Spdy 150'
3/27	
4/3	S.D. 150'
4/10	Spdy 200'
4/17	" 250'
4/24	S.D. 450'
5/1	Drly 850'
5/8	" 1100'
5/15	" 1400'
5/22	" 1805'
5/29	" 2350'
6/5	Top line 2330' Drly 2355'
6/12	" 2520' HFW 2425'
6/18	Set 5" - 2620 T.D. 2632' Pipe did not shut off
6/26	Top line 2330' " Wilcox 2686' T.D. 2699' - HFW Dry & Abandon

Chautauqua

3 Map No. **KANSAS** Sec. 1 Twp. 132 R. 8 <sup>E</sup>

Well No. 1 Westerfield

Syndicate Oil & Gas Co. Company

Contractor

**COMPLETE**

**SECTION PLAT**

990 Ft. from N. Line

Ft. from S. Line

Ft. from E. Line

330 Ft. from W. Line

		0	

**ABANDONED**

Location.....

Rig up.....

Drilling and Remarks:

top L 7330'  
top Milcox 7686'  
D&A 7699' NEW

**RECORD**

Cased..... in., ..... ft.

Sand.....

Gas.....

Oil.....

Total Depth 7699

**PRODUCTION**

1st 24 hrs. Nat.....

1st 24 hrs. after shot.....

Gas..... Cu. Ft.

Dry Hole

Abandoned

Date

**JUN 26 1929**

**CHAS. L. SHERWOOD**  
192..... Scout

Chautauqua E  
132 R. 8

3 **KANSAS** Map No. Sec. 1 Twp. 132 R. 8

Well No. 1 Westersfield

Syndicate Oil & Gas Co. Company

Contractor

**FIRST REPORTS**

**SECTION PLAT**

990 Ft. from N. Line  
Ft. from S. Line  
Ft. from E. Line  
330 Ft. from W. Line

		0	

Location  
Rig up *Apdy 150'*  
Drilling and Remarks:

**RECORD**

Cased..... in., ..... ft.  
Sand.....  
Gas.....  
Oil.....  
Total Depth.....

**PRODUCTION**

1st 24 hrs. Nat.....  
1st 24 hrs. after shot.....  
Gas..... Cu. Ft.  
Dry Hole.....  
Abandoned.....

Date  
**MAR 20 1929**

**CHAS. L. SHERWOOD**

192..... Scout