SIDE ONE

S.C.

STATE CORPORATION COMMISSION OF KANSAS
OIL & GAS CONSERVATION DIVISION
WELL COMPLETION OR RECOMPLETION FORM
ACO-1 WELL HISTORY
DESCRIPTION OF WELL AND LEASE

Operator: License # 5181
Name DONALD C. SLAWSON
Address 104 South Broadway
Wichita, Kansas 67202
City/State/Zip

Purchaser

Operator Contact Person Bill Horigan
Phone (316) 263-3201

Contractor: License # 6039
Name L. D. DRILLING, INC.

Wellsite Geologist Bill Stout
Phone

Designate Type of Completion
X New Well ___ Re-Entry ___ Workover

___ Oil ___ SWD ___ Temp Abd
___ Gas ___ Inj ___ Delayed Comp.
X Dry ___ Other (Core, Water Supply etc.)

If OWWO: old well info as follows:
Operator
Well Name
Comp. Date Old Total Depth

WELL HISTORY

Drilling Method:
X Mud Rotary ___ Air Rotary ___ Cable

6-20-88 | 6-28-88 | 6-28-88
Spud Date | Date Reached TD | Completion Date

4340' |
Total Depth | PBTD

Amount of Surface Pipe Set and Cemented at 311 feet
Multiple Stage Cementing Collar Used? ___ Yes ___ No
If yes, show depth set feet
If alternate 2 completion, cement circulated
from feet depth to w/ SX cmt
Cement Company Name
Invoice #

API NO. 15- 063-21,203

County GOVE

NE SW Sec. 21 Twp. 15 Rge. 29 ___ East X West

1860 Ft North from Southeast Corner of Section
3260 Ft West from Southeast Corner of Section
(Note: Locate well in section plat below)

Lease Name York "BU" Well # 1

Field Name

Producing Formation

Elevation: Ground 2556 KB 2561

Section Plot

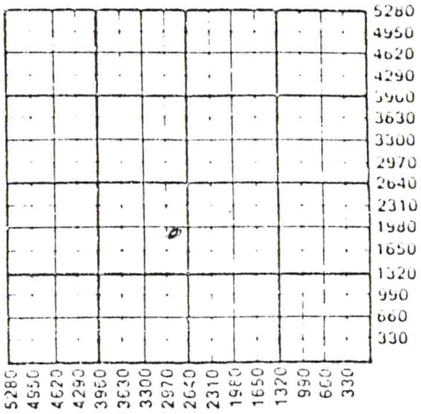

WATER SUPPLY INFORMATION
Disposition of Produced Water: ___ Disposal
Docket # ___ Repressuring

Questions on this portion of the ACO-1 call:
Water Resources Board (913) 296-3717
Source of Water:
Division of Water Resources Permit #

___ Groundwater Ft North from Southeast Corner
(Well) Ft West from Southeast Corner of
Sec Twp Rge ___ East ___ West

___ Surface Water Ft North from Southeast Corner
(Stream, pond etc) Ft West from Southeast Corner
Sec Twp Rge ___ East ___ West

___ Other (explain) water from Dwight York Well
(purchased from city, R.W.D. #)

INSTRUCTIONS: This form shall be completed in triplicate and filed with the Kansas Corporation Commission, 200 Colorado Derby Building, Wichita, Kansas 67202, within 120 days of the spud date of any well. Rule 82-3-130, 82-3-107 and 82-3-106 apply.
Information on side two of this form will be held confidential for a period of 12 months if requested in writing and submitted with the form. See rule 82-3-107 for confidentiality in excess of 12 months.
One copy of all wireline logs and drillers time log shall be attached with this form. Submit CP-4 form with all plugged wells. Submit CP-111 form with all temporarily abandoned wells.

All requirements of the statutes, rules and regulations promulgated to regulate the oil and gas industry have been fully complied with and the statements herein are complete and correct to the best of my knowledge.

Signature William R. Horigan
William R. Horigan
Title Kansas Operations Manager Date 7-12-88

Subscribed and sworn to before me this 12th day of July, 19 88.
Notary Public Jacqueline J. Scheck
Date Commission Expires July 23, 1990

K.C.C. OFFICE USE ONLY
✓ Letter of Confidentiality Attached
✓ Wireline Log Received
___ Drillers Timelog Received
Distribution
___ KCC ___ SWD/Rep ___ NGPA
✓ KGS ___ Plug ___ Other (Specify)

Sec. 21 Twp. 15 Rge. 29 W

Form ACO-1 (5-86)

JUL 14 1988
KANSAS GEOLOGICAL SURVEY
WICHITA BRANCH

JACQUELINE J. SCHECK
NOTARY PUBLIC
STATE OF KANSAS
My Appt. Exp. 7-23-90