
Cowley

KANSAS

SECTION 6 TOWNSHIP 32S RANGE 8E

WELL NO. #4 Jarvis "A"

COMPANY Skelly Oil Co.

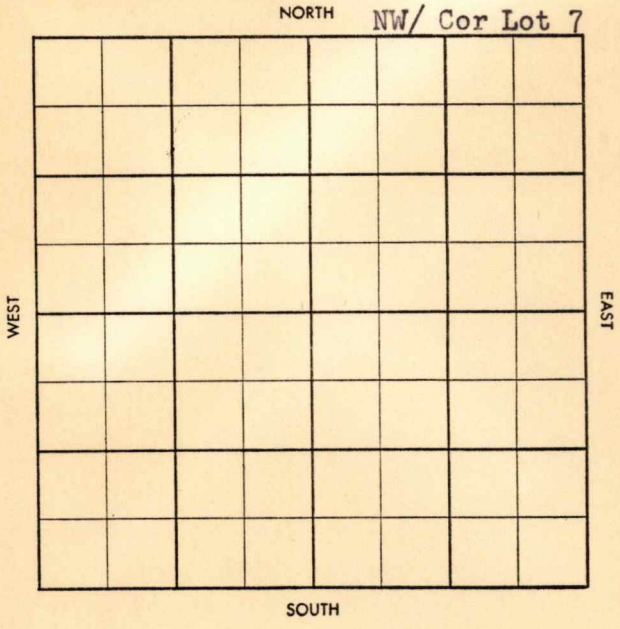

FORM 504-3 SUNRAY

Twp. X Pool X

Co. X Feet X

S-513-B

County Cowley Elev. 1357 GF

Sec. 6 Twp. 32 Rge. 8E

Company Skelly Oil Co.

Farm Name Jarvis "A" No. 4

TOPS	DEPTH	LOG	DATUM
Anh.			
Tp.			
H.			
Tr.			
Dg.			
B. L.			
X. Lay A. Sh 1973			
Lay B. Sh 2001			
Lay C Sh 2020			
Ce.			
C.			
M.			
M.			
K.			
Mz.			
Mq.			
V.			
S.			
S.			
A.			
R.			
Pf.			
G.			
T.D.			

Loc. in Sec. NW/Cor Lot 7

Geol.

Contr.

Pool Windsor

COMPLETE
JUL 2 '58

Date Comm. 6-4-58

8" @ 150 w/130, Core 1973½-2003 - full rec. show oil, RTD 2033, 5" @ 2031 RUCT JUN 18 '58

2 4/1975-81 frac pkd JUN 25 '58

[redacted] - JUL 2 '58 P 25 BO + 58 BW

pd Loy 1975-81

Co. Lse No. Sec. T. R.

Twp. X Pool X

Co. X Facet ~~X~~

S–513–B

County Cowley Elev.

Sec. 6 Twp. 32 Rge. 8E

Company Skelly Oil Co.

Farm Name Jarvis "A" No. 4

TOPS	DEPTH	LOG	DATUM
Anh.			
Tp.			
H.			
Tr.			
Dg.			
B.L.			
x Lay A. Sd 1973			
xLay B. Sd 2001			
xxLay C Sd 2020			
Ce.			
C.			
M.			
M.			
K.			
Mz.			
Mq.			
V.			
S.			
S.			
A.			
R.			
Pf.			
G.			
T.D.			

Loc. in Sec. NW/Cor Lot 7

Geol.

Contr.

Pool Windsor

JUN 1 '58 FIRST REPORT

Date Comm. 6-4-58

8" @ 150 w/130, Core 1973½=2003 - full rec. show oil, RTD 2033, 5" @ 2031 RUCT

Co. Lse. No. Sec. T. R.