

Cowley


KANSAS

SECTION 6 TOWNSHIP 32S RANGE 8E

WELL NO. #8 Jarvis 'E'

COMPANY McNeish & Gralapp

NORTH SE Cor Lot 6

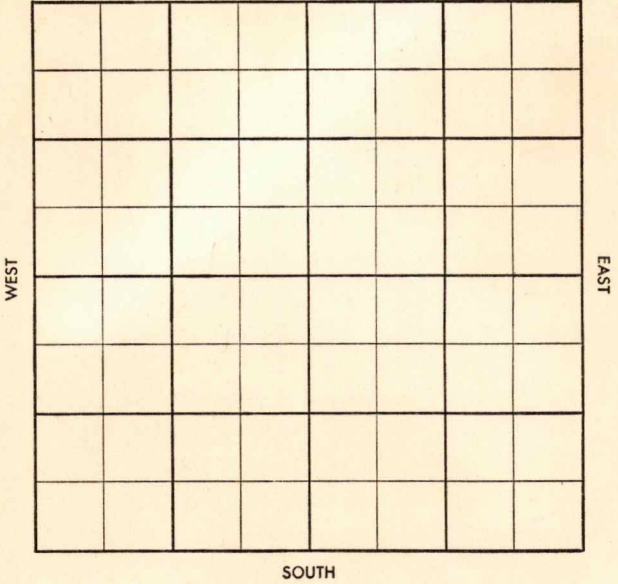

Twp. ~~Pool~~
 Co. ~~Facet~~

CORRECTION

9-513-B

County Cowley Elev. 1318 Gr
 Sec. 6 Twp. 32 Rge. 8E
 Company McNeish & Gralapp
 Farm Name Jarvis "E" No. 8

TOPS	DEPTH	LOG	DATUM
Anh. <u>107ah</u>		<u>1460</u>	
Tp. <u>5721</u>		<u>1520</u>	
H. <u>5721</u>		<u>1662</u>	
Tr. <u>409</u>		<u>1893</u>	
Dg. <u>L2y sd</u>		<u>1982</u>	
B. L.			
L.			
K.C.		<u>1997</u>	
B.K.C.			
Ce.			
C.			
M.			
M.			
K.			
Mz.			
Mq.			
V.			
S.			
S.			
A.			
R.			
Pf.			
G.			
T.D.	<u>2010</u>		

Loc. in Sec. _____
SE cor lot 6
990' fnl x
6980' fel
 Geol. _____
 Contr. _____
 Pool _____
Windsor SW

COMPLETE
 APR 9 '58

Date Comm. 3-1-58 8" 150
 Location 5" 1520 west
CO 1580 SW DW

⊕

Co.
Lse.
No.
Sec.
T.
R.

30

County Cowley Elev. 1318 Gr

Sec. 6 Twp. 32 Rge. 8E

Company McNeish & Galapp

Farm Name Jarvis No. 8

TOPS	DEPTH	LOG	DATUM
Anh.			
Tp.			
H.			
Tr.			
Dg.			
B.L.			
L.			
K.C.			
B.K.C.			
Ce.			
C.			
M.			
M.			
K.			
Mz.			
Mq.			
V.			
S.			
S.			
A.			
R.			
Pf.			
G.			
T.D.			

Loc. in Sec. SE cor lot 6

990' fnl x

6980' fel

Geol. _____

Contr. _____

Pool Windsor SW



Date Comm. _____

Location

Co.

Lse.

No.

Sec.

T.

R.