


Section 34 Township 16 Range 10-W

Well No. #1 Schroeder "C"

Company Cities Service Oil et al

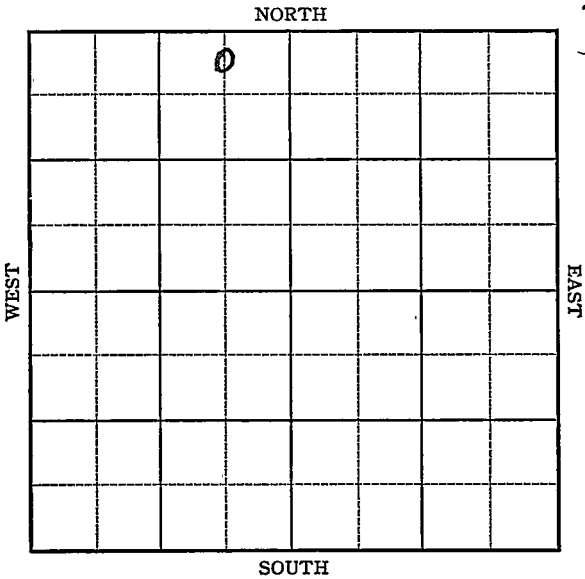

Sec. 34 Twp. 16 R. 10-W

Well No. #1 Schroeder "E" "C" Farm

Cities Service Oil Company

(Stoltenberg)


330 Ft. from N. Line

_____ Ft. from S. Line

660 Ft. from E. Line

_____ Ft. from W. Line

Elev. 1822

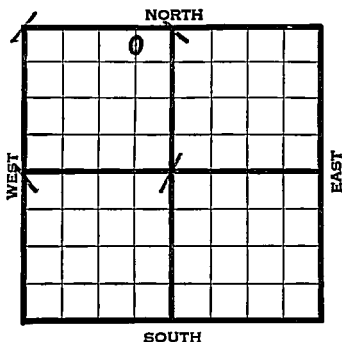

1941	REPORT
9/24	Derrick.
10/2	8" - 335' Drlg. 2550'
10/9	Drlg. 3102'
10/16	Lans. 2950' Arb. 3285-86' T.D.
	5" - 3286' Drlg. 3307' S.S.O.
10/23	T.D. 3307' 3000 acid.
	Pump 78 oil in 8 hours.
10/30	Shut down.
11/5	Arb. 3285'
	5" - 3286'
	T.D. 3307'
	3000 acid.
	Potential 219 bbls., pump.
	44. Gravity
	COMPLETED


Map No. K-55 Sec. 34 Twp. 16 R. 10WWell No. 1 Schroeder "E"Cities Service Oil Company**FIRST REPORT**

etal

Contractor

C NL NE NW

SECTION PLAT

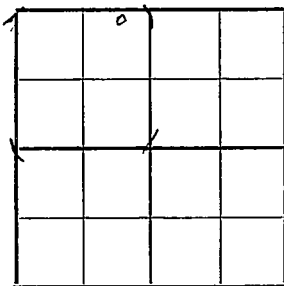330 Ft. from N. Line Ft. from S. Line660 Ft. from E. Line Ft. from W. Line

STOLTENBERG POOL

Location Rig up

Drilling and Remarks:

Derrick

RECORD

Cased in., ft.Sand Gas Oil Total Depth

PRODUCTION

1st 24 hrs. Nat. 1st 24 hrs. after shot Gas Cu. Ft.Dry Hole Abandoned

Date

SEP 24 1941 19S. J. LEWIS Scout

Map No. K-55 Sec. 34 Twp. 16 R. 10WWell No. 1 Schroeder "C"Cities Service Oil et al CompanyCORRECTION

Contractor

C NL NE NW

330 Ft. from N. Line Ft. from S. Line660 Ft. from E. Line Ft. from W. Line

SECTION PLAT

	o		

STOLTENBERG POOL

Location _____

Rig up _____

Drilling and Remarks:

Reported as
#1 Schroeder "E"

RECORD

Cased _____ in., _____ ft.

Sand _____

Gas _____

Oil _____

Total Depth _____

PRODUCTION

1st 24 hrs. Nat. _____

1st 24 hrs. after shot _____

Gas _____ Cu. Ft.

Dry Hole _____

Abandoned _____

Date

OCT 1 1941S. J. LEWIS Scout

Ellsworth

KANSAS

Map No. 7-85 Sec. 34 Twp. 16 R. 10W

Well No. 1 Schroeder "C"

Cities Service Oil Company

COMPLETED Contractor

C NL NE NW

SECTION PLAT

330 Ft. from N. Line

_____ Ft. from S. Line

660 Ft. from E. Line

_____ Ft. from W. Line

	o		

ST OLTENBERG POOL

Location _____

Rig up _____

Drilling and Remarks:

*CR + 3285.
5" @ 3286.
3000 acid
Pump 219 P.D.*

442 Gr.

RECORD

Cased _____ in., _____ ft.

Sand _____

Gas _____

Oil _____

Total Depth 3307

PRODUCTION

1st 24 hrs. Nat. _____

1st 24 hrs. after shot _____

Gas _____ Cu. Ft.

Dry Hole _____

Abandoned _____

Date

NOV 5 1941 19

S. J. LEWIS

Scout